


DATE 10/12/18

TOWN OF LEXINGTON — BOARD OF PUBLIC WORKS
SEWER DIVISION

Sketch of Service Here

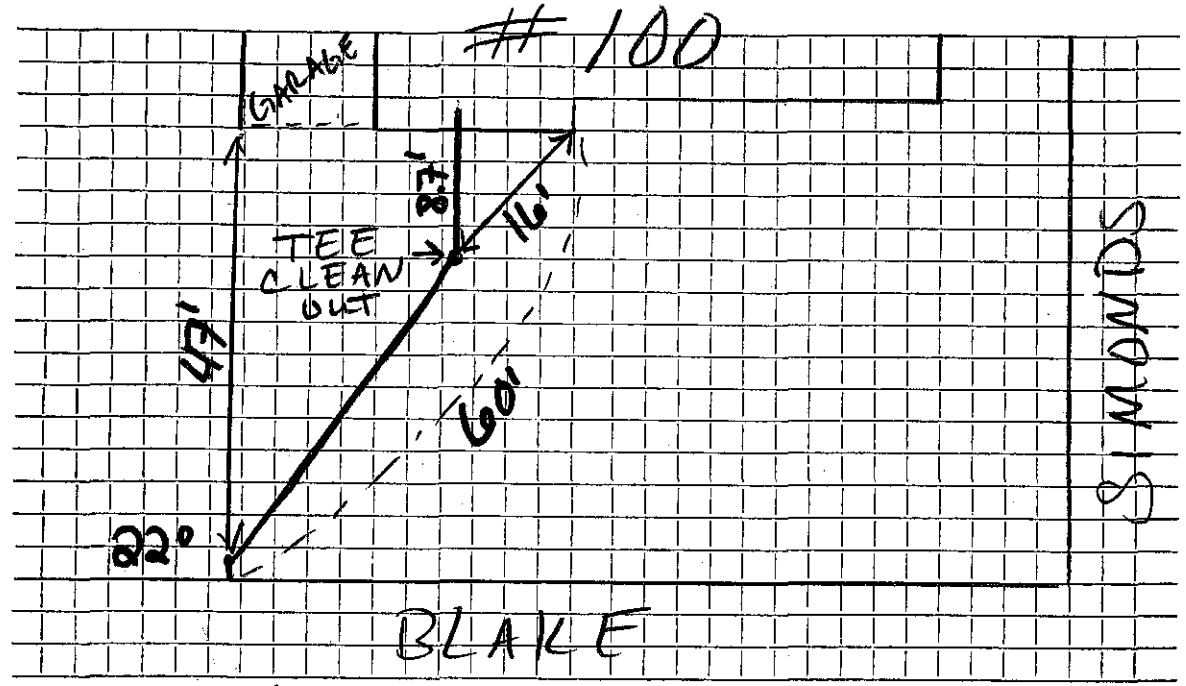

Connection made in ... Blake Rd ... Street. Work completed

Remarks:
.....
.....