

Name R. H. Haynes

Service No. 73 1122

Address

103 Simonds Road

Location 103 Simonds Road

Kind of Pipe

Size 6"

Size of Main 8"

~~Report Known~~—New Service

Location

Date	Material	Amount	Total	Date	Amount
11/10/47	Labor	4 40		11/8/47	150 00
11/11/47		46 84		12/31/47	9 28
11/13/47		36 80	88 04		140 72
	10% Overhead		8 80		
	60' 6" Sewer Pipe		15 60		
	1 6" Elbow		1 18		
	Joint Compound		3 60		
	1 hr. Hired Shovel @ 7.00		7 00		
	3 hrs. Trucking @ .75		1 50		
	Patching. 15x3		15 00		
			140 72		
	Labor			6/25/68	Ports
	Con. 12/31/47				

TOWN OF LEXINGTON—DEPT. OF PUBLIC WORKS

SEWER DIVISION

DATE

NO.


The undersigned applies for the construction of a particular sewer connecting No.
Street and hereby agrees to comply with the Rules and Regulations governing the construction and use of Particular
Sewers, as now or at any future time established by the Board of Selectmen.

Am't of estimate \$.....

Am't Paid \$.....

..... Owner

Sketch of Service Here **103**

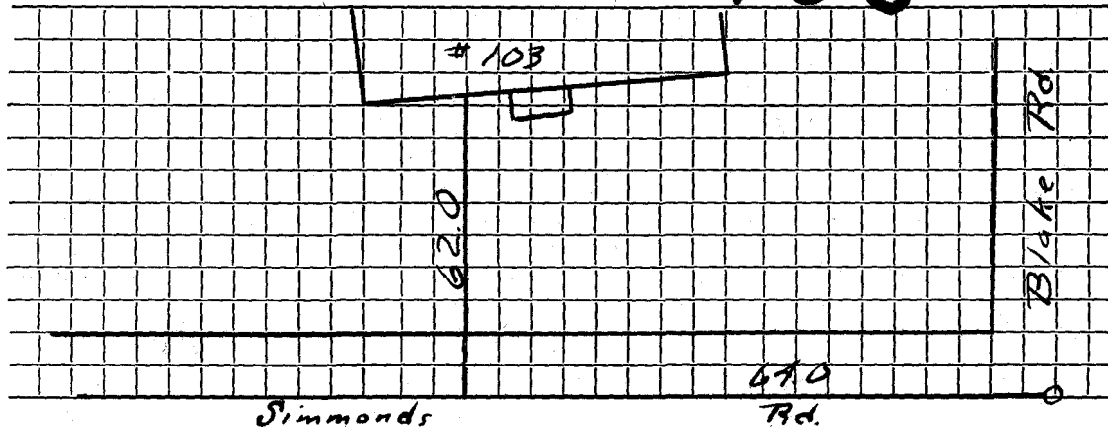

Connection made in Street.

Work completed 19..

Remarks: