

Name Irving Sherwood

Service No. 72 1121

Address 105 Simonds Road

105 Simonds Road

Location 105 Simonds Road

Kind of Pipe

Size 6"

Size of Main 8"

~~Repair~~ ~~Renewal~~ ~~New Service~~

Location

Date	Material	Amount	Total	Date	Amount
11/10/47	Labor	54 53		11/7/47	125 00
11/13/47		36 80	91 33	May 21 48	12 07
	10% Overhead		9 13		187 07
	50' 6" Sewer Pipe @ .26		13 00		
	1 6" Elbow		1 18		
	Joint Compound		3 00		
	3 lbs. Dynamite @ 21		63		
	5 Exploders @ .11		55		
	1 hr. Compressor		1 75		
	2 hrs. Trucking		1 50		
	Patching 15x3		15 00		
	LABOR		137 07		
3/3/83	1 REPAIR W.O. # 408 6" x 8" 360 Repair Clamp				
	1 6" Clay to AC Fernco Adapt.				
	3' x 6" Transite pipe				

TOWN OF LEXINGTON—DEPT. OF PUBLIC WORKS

SEWER DIVISION

DATE

NO.

The undersigned applies for the construction of a particular sewer connecting No. Street and hereby agrees to comply with the Rules and Regulations governing the construction and use of Particular Sewers, as now or at any future time established by the Board of Selectmen.


Am't of estimate \$.....

Am't Paid \$.....

..... Owner

Sketch of Service Here

105

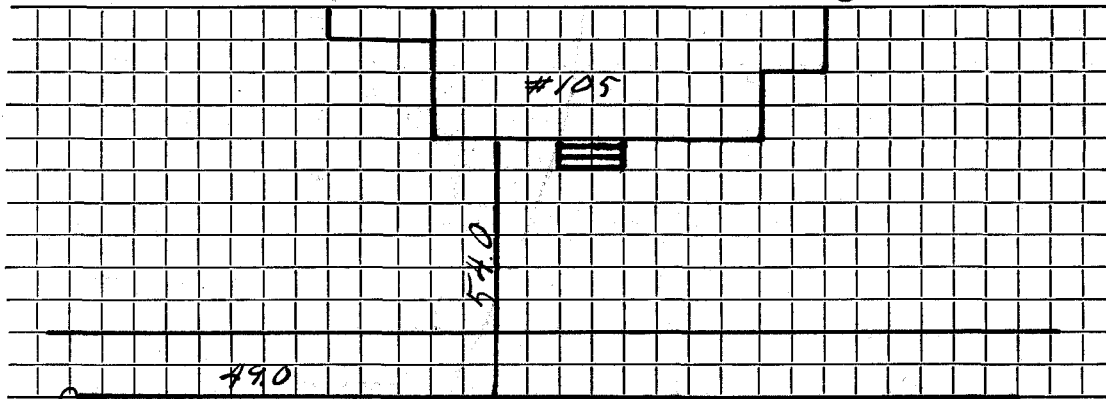

Connection made in Street.

Work completed 19..

Remarks: