

Name Robert Jeremiah

Service No. 227 (1957)

Address 109 Simonds Road

109 Simonds Road

Location Comm. 6-2-58

Kind of Pipe

Size 6"

Size of Main 8"

- Repair - Renewal - New Service

Location

Date	Material	Amount	Total	Date	Amount
4/15/58	Labor	65 08		12-5-57	\$ 20000
	10% overhead	6 51	71 59	6-2-58	Refund
	30' - 6" Transite Pipe @ .70		21 00		\$ 142.71
	1 - 6" 45° Transite Elbow		2 79		
	1 - 6" 90° " "		5 29		
	1 - 6" Clay Bend		1 24		
	1 - 6" 11¼° Transite Bend		5 10		
	1 - 6" 22½° " "		6 21		
	2 hrs. Town Shovel @ 6.50		13 00		
	3 hrs. Trucking @ .75		2 25		
	Patch 12x3 (to be done)		12 00		
			<u>142 71</u>		
	Labor				

TOWN OF LEXINGTON—DEPT. OF PUBLIC WORKS
SEWER DIVISION

DATE.....

NO.


The undersigned applies for the construction of a particular sewer connecting No.....
Street and hereby agrees to comply with the Rules and Regulations governing the construction and use of Particular
Sewers, as now or at any future time established by the Board of Selectmen.

Am't of estimate \$.....

Am't Paid \$.....

..... Owner

Sketch of Service Here

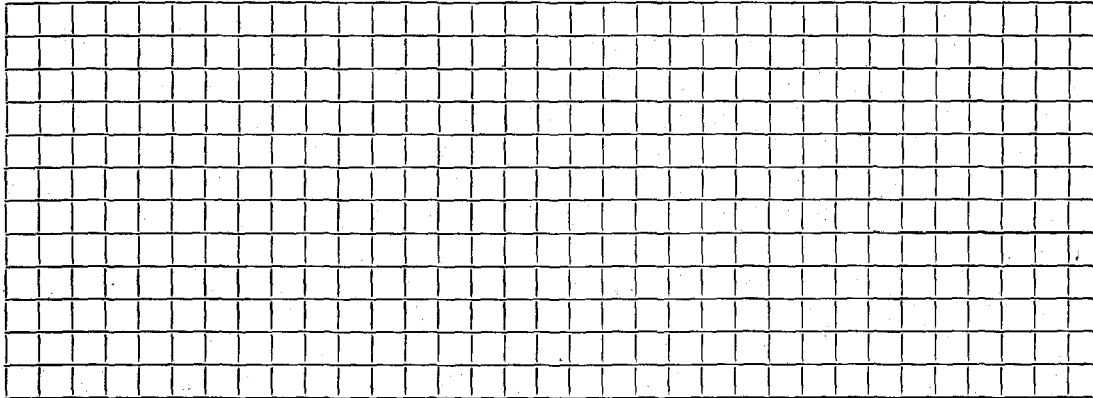

Connection made in..... Street.

Work completed.....19..

Remarks: