

Name Donald Burke

Service No. 45 44

Address 120 Simonds Road

120 Simonds Road

Location

Kind of Pipe

Size 6"

Size of Main 8"

~~Repair/Reconnect~~ New Service

Location Camm 5-16-60

Date	Material	Amount	Total	Date	Amount
4-25-60	Labor	70 56		4-21-60	Deposit 150 00
	10% O.H.	7 06	77 62	5-16-60	Paid by W.H.C. #45 18 00
	70' 6" Transite pipe @78		54 60	5-24-60	Paid 34 67
	1 22 $\frac{1}{2}$ " <sup>o</sup> Transite Bend		6 21		202 67
	1 11 $\frac{1}{4}$ " <sup>o</sup> Transite Bend		5 10		
	1 11 $\frac{1}{4}$ " <sup>o</sup> Transite Elbow		2 24		
	1 6" Duplex Adapters		1 90		
	23x3 Patch		23 00		
	4 Hrs Insley Shovel @6.50		26 00		
	2 Hrs Trucking @3.00		6 00		
			202 67		
				10-31-49	Reeds & Stone 14 Main
				16-14-87	S.D.
				Bill sent 5-16-60	34.67


DATE \_\_\_\_\_

TOWN OF LEXINGTON — BOARD OF PUBLIC WORKS

SEWER DIVISION

Sketch of Service Here

120

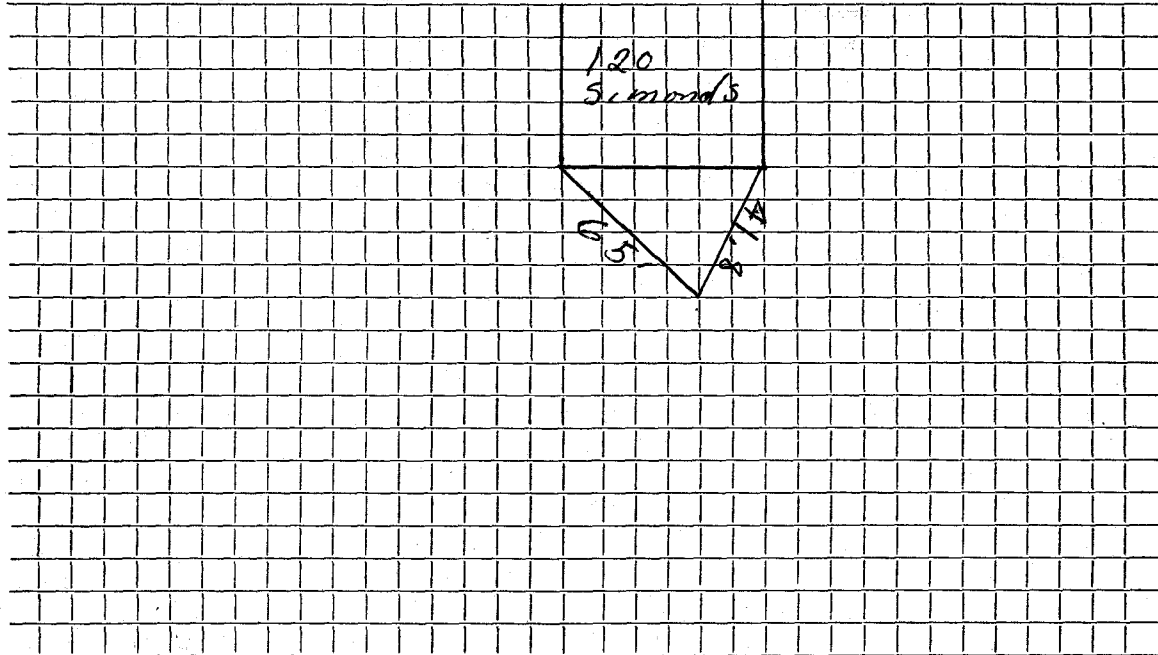

Connection made in ..... Street. Work completed .....

Remarks: .....

.....

.....