

Name

Service No.

Address 127 Simonds Road

127 Simonds Road

Location

Kind of Pipe

Size 6"

Size of Main 8"

Repair—Renewal—New Service W.O. # 8773 (Lower Sewer Service)

Location

Date	Material	Amount	Total	Date		Amount
6-3-58						
	52' 6" Transite					
	1 6"-11 1/4° Bend					
	3 6"-11 1/4° Elbow			7/27/71	OUTSIDE Labor	95 34
	1 6" Clay Elbow			8/23/71	"	35 66
					20' 6" Transite pipe .90	18 00
					3 3"x6" Nipple	8 10
					1 5"x6" Nipple	4 50
					1 22" Sweep	6 83
					1 450 MI	4 89
					1 6x6 Wye	9 37
					1/2 6" Cap	2 55
					1/2 Bag cement 1.95	98
					1 Ton cold patch	8 00
					1 1/2 " hot top 7.45	14 90
					2 Hrs. Truck 3.00	6 00
					1 " "	1 50
					3/4 " Shovel 4.00	12 00
					1/2 " Roller 2.00	1 00
					Trailer	2 00
						231 82

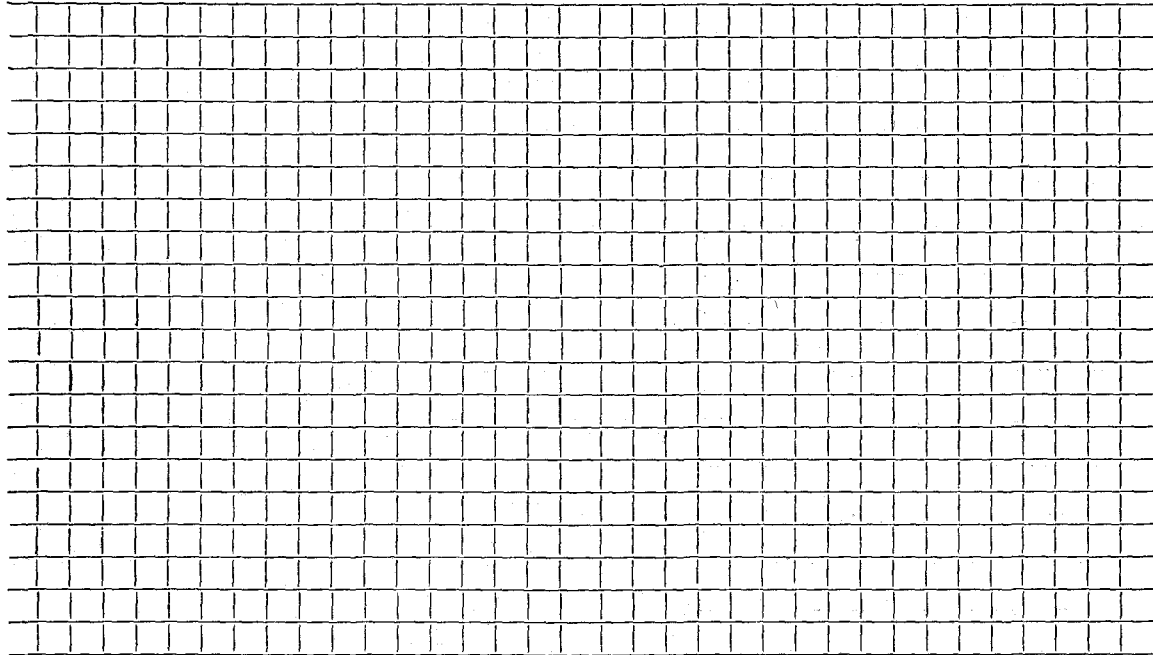
1-12-71 Roots

DATE _____

TOWN OF LEXINGTON — BOARD OF PUBLIC WORKS

SEWER DIVISION

Sketch of Service Here

A large rectangular grid of graph paper, consisting of approximately 20 columns and 25 rows of small squares, intended for sketching sewer service details.

Connection made in Street. Work completed

Remarks:

.....

.....