

Name D. G. Miller

Service No. 171

Address 135 Simonds Road

135 Simonds Road

Location

Kind of Pipe Valeri Const. Co. Permit #134

Size 6"

Size of Main 8"

~~Repair - Renewal~~ - New Service W.O. #9301

Location

FEB 15 1965


Date	Material	Amount	Total	Date	Amount	
11-4-64	Labor	52 48		10-14-64	Deposit	125 00
	10% O.H.	5 25	57 73	2-15-65	Retained	6 82
20'	6" Transite pipe @.82		16 40	7-26-71	Lower Service	118 18
1	90° Elbow		4 09		10' 6" Transite	
1	12" Nipple		1 21		3 6"-3' Nipples	
	20 X 3 Patch		20 00		3 6"-2' Nipples	
1	6 X 8 Saddle		5 25		2 6"-11 1/4° Sweeps	
1	Hr. Town Shovel		6 50		1 6"-11 1/4° Elbow	
1	Hr. Town Truck		3 00		1 6"-45° Elbow	
1	Hr. Loader		4 00		1 6" X 6" Wye	
			118 18		1 6"-6" Nipple	
11-9-64	40' 6" A C Transite pipe					

DATE \_\_\_\_\_

TOWN OF LEXINGTON — BOARD OF PUBLIC WORKS  
SEWER DIVISION

Sketch of Service Here

135

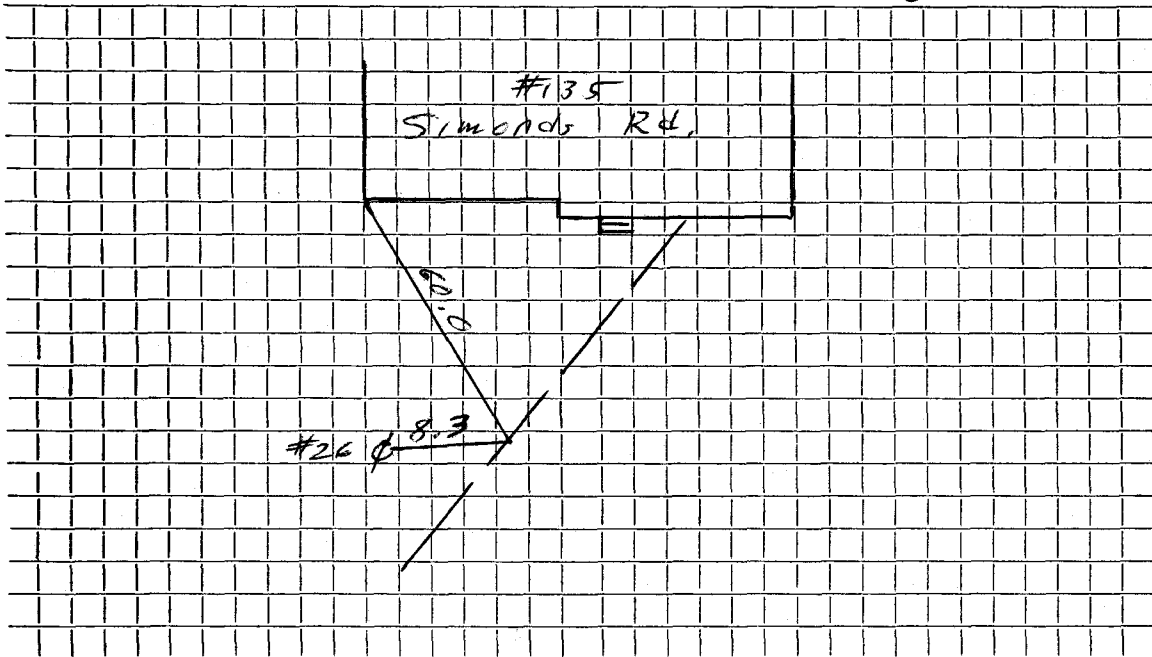

Connection made in ..... Street.      Work completed .....

Remarks: .....  
.....  
.....