

Name John F. Power

Service No. 116

Address 138 Simonds Road

138 Simonds Road

Location

Kind of Pipe

Size 6"

Size of Main 8"

~~*Repair~~ ~~—Renewal~~ ~~—New Service*~~ W.O. #7631

Location JAN 27 1969


Date	Material	Amount	Total	Date	Amount
11/14/68	Labor		59 04	11-12-68	200 00
	10% O.H.		5 90	1-27-69	43 42
	32" 6" Transitepipe .88		28 16		111 33
	1/2 Bag Cement 1.55		78		
	8 Brick		35		
	1/2 Yd. Loam 3.50		1 75		
	1 lb. seed		1 10		
	1 1/2 Hr. Trucking 3.00		4 50		
	1 1/2 " Shovel 6.50		9 75		
			111 33		
	Pro-Rated 111.33 x 9yrs. 6mo. *		42 42		
	25				
				8-13-67	Roots
				11-14-68	Roots
				8-14-68	Sewer Block
				12-23 67	Sewer Main

DATE _____

TOWN OF LEXINGTON — BOARD OF PUBLIC WORKS

SEWER DIVISION

Sketch of Service Here

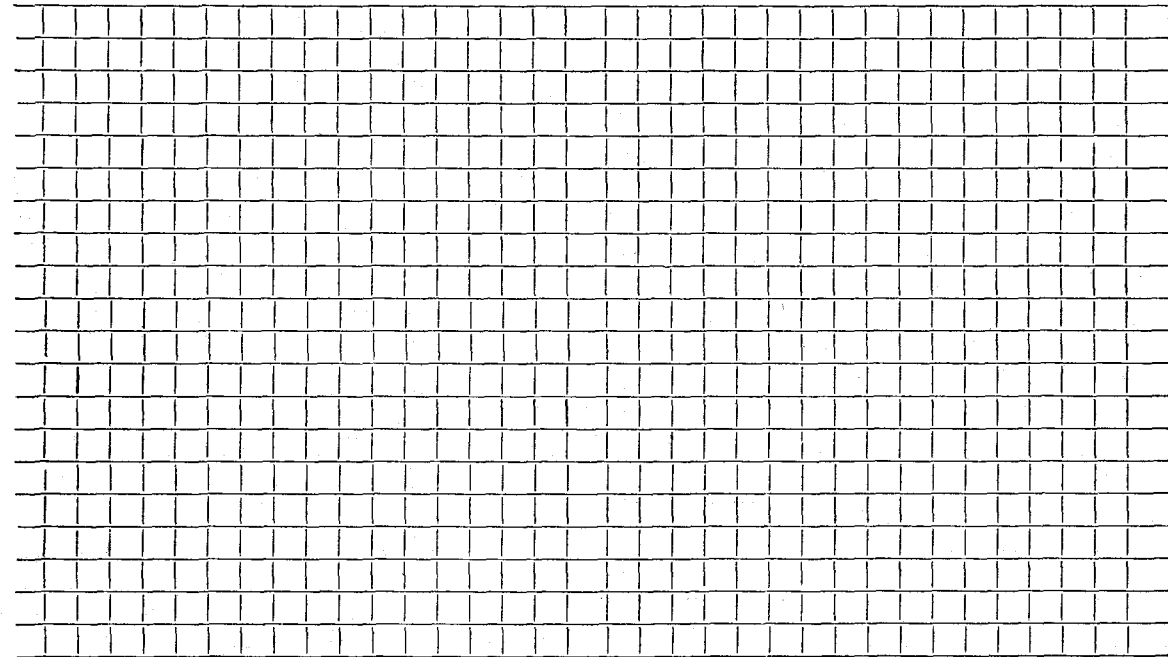

Connection made in Street. Work completed

Remarks: *Original Service 5-4-59 (44'-6" Transite)*

.....
.....