

Name

Service No.

Address

152 Simmonds Rd

Location

Kind of Pipe

Size

Size of Main

Repair—Renewal—New Service

Location

Date

Material

Amount

Total

Date

Amount

6-2-04

REPAIR MADE INSIDE

6X6X6 WYE CLEAN OUT


6X6 PVC TO CLAY FRENCH

9 1/2' - 6" PVC

DATE _____

TOWN OF LEXINGTON — BOARD OF PUBLIC WORKS
SEWER DIVISION

Sketch of Service Here

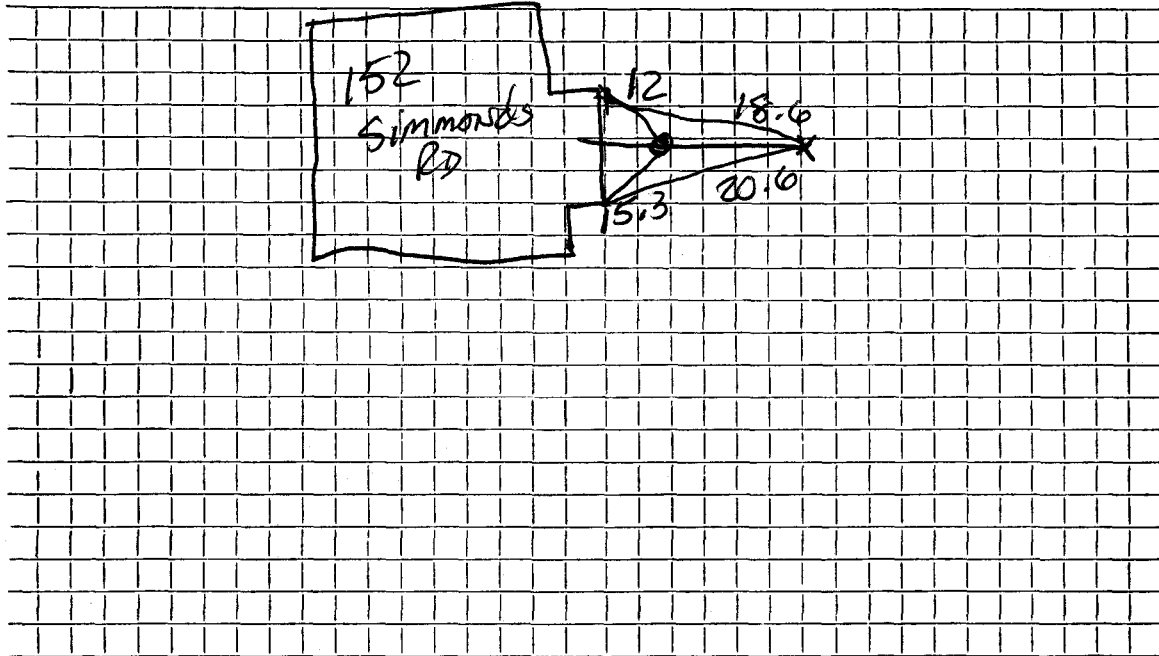

Connection made in Street. Work completed

Remarks: *Service goes out to Burlington St.*