

Name Earle C. Banks

Service No. 8.

Address 31 Simonds Road

31 Simonds Road

Location

31 Simonds Road

Kind of Pipe

Size 6"

Size of Main 8"

~~Repair~~ ~~Renewal~~ New Service

Com. 5/28/51

Location

Date	Material	Amount	Total	Date	Amount
3/22/51	Labor	29 80	29 80	12-13-51	Deposited 175 00
	10% Overhead		2 98	8-2-51	Refunded (63 26)
	46'-6" Sewer Pipe @ .344		15 82		111 74
	1 - 6" Elbow		1 88		
	Joint Compound		2 76		
	6 Hrs. Littlefield Shovel		42 00		
	2 Hrs. Trucking		1 50		
	Patching 15x3		15 00		
			111 74		
	Labor			11-11-74	Roots 33' out
				4/26/65	Roots

**TOWN OF LEXINGTON—DEPT. OF PUBLIC WORKS
SEWER DIVISION**

DATE

NO.


The undersigned applies for the construction of a particular sewer connecting No.
Street and hereby agrees to comply with the Rules and Regulations governing the construction and use of Particular
Sewers, as now or at any future time established by the Board of Selectmen.

Am't of estimate \$.

Am't Paid \$.

..... Owner

Sketch of Service Here

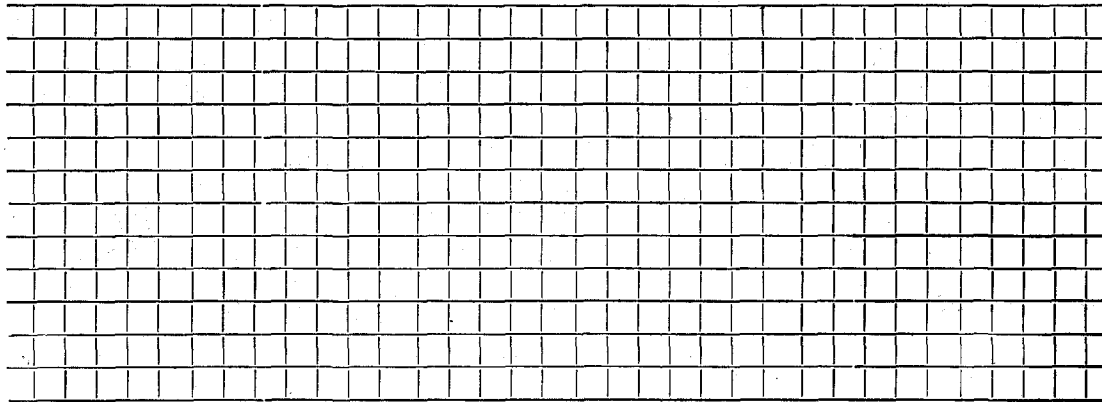

Connection made in Street.

Work completed 19..

Remarks: