

Name Mrs. G. Nelson

Service No. 152.

Address 32 Simonds Road

Lexington 32 Simonds Road Location

Kind of Pipe

Size 6"

Size of Main 8"

~~Repair - Renewal~~ New Service

Committed 12.8-52

Location

Date	Material	Amount	Total	Date	Amount
11/18/52	Labor	20 58			
	10% Overhead	2 06	22 64	<i>9-30-52 Deposited</i>	<i>125 00</i>
	48' - 6" sewer pipe @ .342		16 42	<i>12-8-52 Refunded</i>	<i>(27 56)</i>
	joint compound		2 88		<i>97 44</i>
	6 hrs. Littlefield shovel @ .7		42 00		
	2 hrs. trucking @ .75		1 50		
	patching 12 X 3		<u>12 00</u>		
			<u>97 44</u>		
	Labor				

TOWN OF LEXINGTON—DEPT. OF PUBLIC WORKS

SEWER DIVISION

DATE

NO.

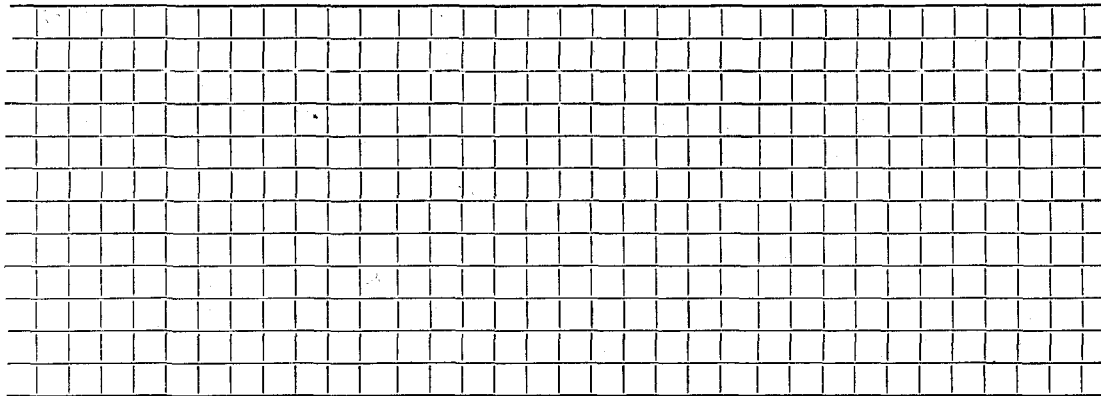
The undersigned applies for the construction of a particular sewer connecting No. Street and hereby agrees to comply with the Rules and Regulations governing the construction and use of Particular Sewers, as now or at any future time established by the Board of Selectmen.

Am't of estimate \$.....

Am't Paid \$.....

..... Owner

Sketch of Service Here

A large rectangular area filled with a grid of small squares, intended for drawing a sketch of the sewer service.

Connection made in Street.

Work completed 19..

Remarks: