

Name May. S. StoneService No. 75 1124

Address

36 Simonds RoadLocation 36 Simonds Road

Kind of Pipe

Size 6"Size of Main 8"~~Repair/Removal~~ New Service

Location

| Date        | Material                 | Amount | Total         | Date        | Amount |
|-------------|--------------------------|--------|---------------|-------------|--------|
| Nov. 24 '47 | Labor                    | 51 65  |               | Nov. 10 '47 | 125 00 |
| 25          | Labor                    | 3 80   | 55 45         | Dec. 31 '47 | 7 47   |
|             | 10% Overhead             |        | 5 55          |             | 117 53 |
|             | 54' 6" Sewer Pipe @ .26  |        | 14 04         |             |        |
|             | Joint Compound           |        | 3 24          |             |        |
|             | Hired Shovel 3 hrs. 7.00 |        | 21 00         |             |        |
|             | Compressor 1 hr.         |        | 1 75          |             |        |
|             | Trucking 2 hrs. @ .75    |        | 1 50          |             |        |
|             | Patching 15 x 3          |        | 15 00         |             |        |
|             |                          |        | <u>117 53</u> |             |        |
|             | <b>Labor</b>             |        |               |             |        |
|             | <i>Con. 12/31/47</i>     |        |               |             |        |
|             |                          |        |               | 9-7-65      | ROOTS  |
|             |                          |        |               | 3-7-66      | ROOTS  |

**TOWN OF LEXINGTON—DEPT. OF PUBLIC WORKS**  
**SEWER DIVISION**

DATE .....

NO. ....


The undersigned applies for the construction of a particular sewer connecting No. ....  
 Street and hereby agrees to comply with the Rules and Regulations governing the construction and use of Particular  
 Sewers, as now or at any future time established by the Board of Selectmen.

Am't of estimate \$.....

Am't Paid \$.....

..... Owner

Sketch of Service Here **36**

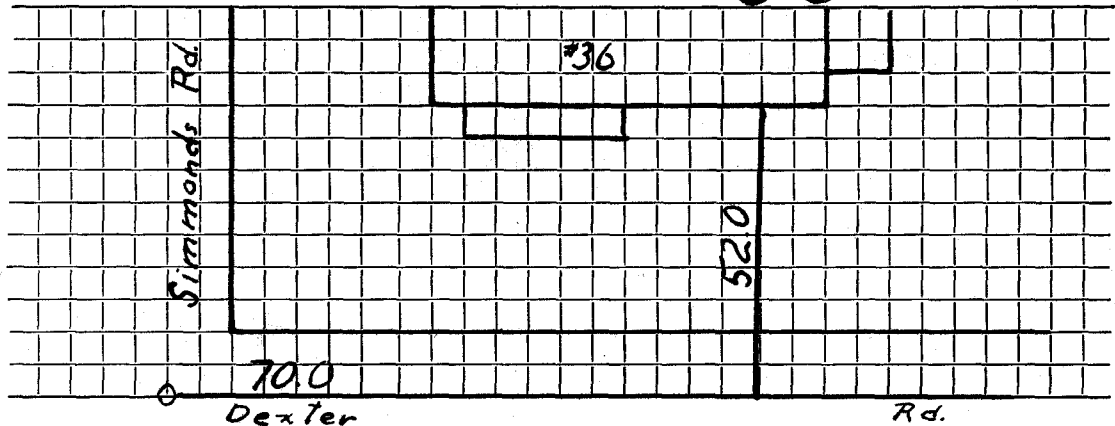

Connection made in ..... Street.

Work completed ..... 19..

Remarks: