

Name Alfred Smart

Service No. ⁵³ 1102

Address 61 Simonds Road

Lexington, Mass.

Location 61 Simonds Road

Kind of Pipe

Size 6"

Size of Main 8"

~~Repair/Renewal~~ New Service

Location

Date	Material	Amount	Total	Date		Amount
Oct. 27, '47	Labor	36 00	36 00	Oct. 25 '47	<i>Deposited</i>	125 00
	10% Overhead		3 60	Nov. 29 '47	<i>Refunded</i>	26 54
	68' - 6" Sewer Pipe @ .26		17 68			98 46
	1 - 6" Elbow		1 18			
	Shovel 5½ hrs. @ 7.00		38 50			
	Trucking 2 hrs. @ .75		1 50			
			<u>98 46</u>			
	Labor					
	<i>Com 11 24 '47</i>					

TOWN OF LEXINGTON—DEPT. OF PUBLIC WORKS

SEWER DIVISION

DATE

NO.


The undersigned applies for the construction of a particular sewer connecting No. Street and hereby agrees to comply with the Rules and Regulations governing the construction and use of Particular Sewers, as now or at any future time established by the Board of Selectmen.

Am't of estimate \$..... *18 Maple Avenue*

Am't Paid \$..... *Resident Man*

..... Owner

Sketch of Service Here **61**

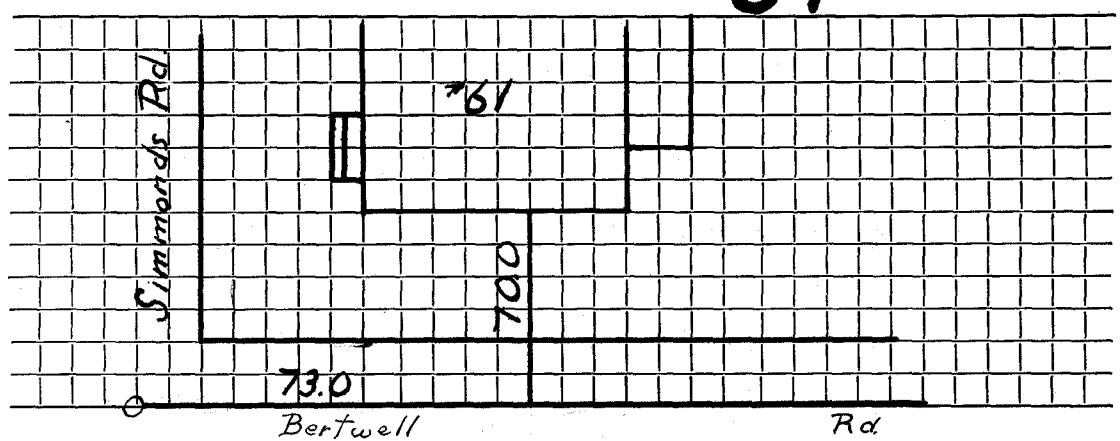

Connection made in Street.

Work completed 19..

Remarks: