

Name

John M. Riley

Service No. 126

Address

62 SIMONDS ROAD

62 Simonds Road

Location

Kind of Pipe

Size 6"

Size of Main 8"

~~Repair—Renewal—Main~~

W.O. # 2767

Location FEB 10 1975

| Date     | Material         | Amount | Total    | Date     | Amount                    |
|----------|------------------|--------|----------|----------|---------------------------|
| 11-21-74 | Labor            | 143 70 |          |          | <u>Non-Charge Work</u>    |
| 12-05-74 | Labor            | 19 59  |          | 11-21-74 | Labor                     |
|          |                  | 161 29 |          |          | 12' 6" Transite Pipe 1.24 |
|          | 10% O.H.         | 16 13  | 177 42   |          | 1/4 Bag Cement            |
| 40'      | 6" Transite Pipe | 1 24   | 49 60    |          | 8 Bricks @.13             |
|          | 1/4 Bag Cement   |        | 55       |          | 1 Yd. Loam @5.00          |
| 12       | Bricks           | 13     | 1 56     |          | 1 Lb. Grass Seed @.95     |
| 4        | Yards Loam       | 5 00   | 20 00    |          | 1 Ton Cold Patch          |
| 3        | Lbs. Grass Seed  | 95     | 2 85     |          | 1 Hr. Trucking @3.00      |
| 2        | Hrs. Trucking    | 3 00   | 6 00     |          | 2 Hrs. Town Shovel 6.50   |
| 3        | Hrs. Trucking    | 1 50   | 4 50     |          |                           |
| 2        | Hrs. Town Shovel | 6 50   | 13 00    | 11-21-74 | Deposit                   |
| 1        | Hr. Compressor   | 5 00   | 5 00     | 3-10-75  | Refund                    |
| 1        | Patch 8'x10'     |        | 68 04    |          |                           |
|          |                  |        | \$348 52 |          |                           |
|          |                  |        |          | 4-27-74  | Roots                     |


550 00  
301 48  
348 52

DATE \_\_\_\_\_

TOWN OF LEXINGTON — BOARD OF PUBLIC WORKS

SEWER DIVISION

Sketch of Service Here

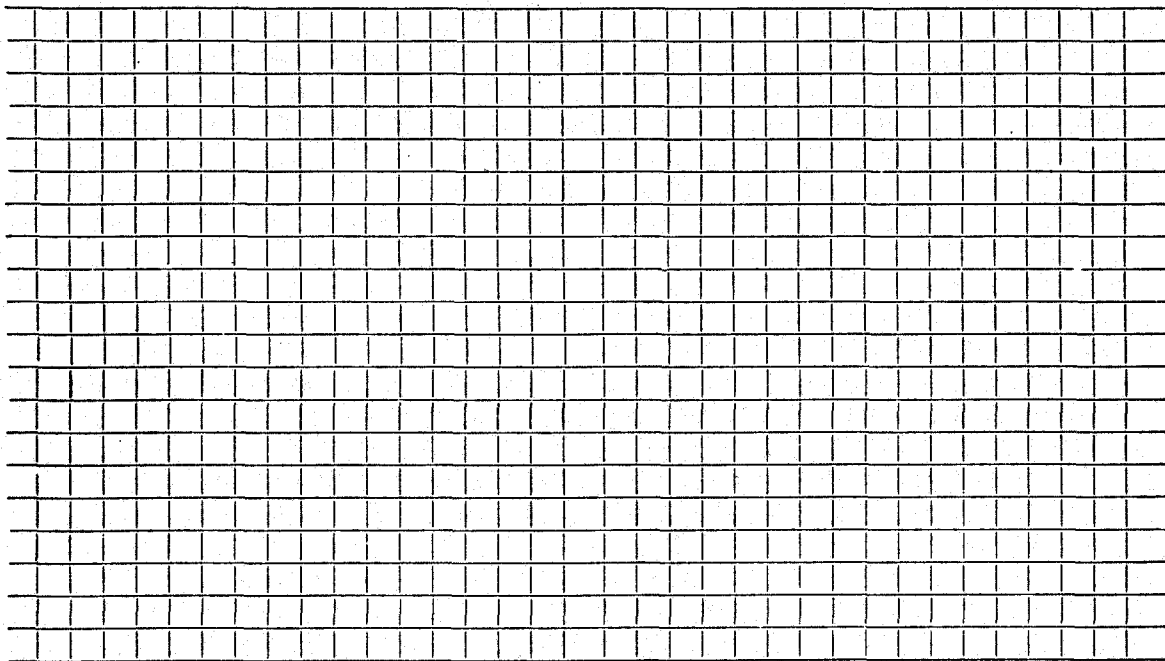

Connection made in ..... Street. Work completed .....

Remarks: *Original Service 11-15-51 (60'-6" Sewer Pipe, 1-6" Elbow)*.....

.....  
.....