

Name Clayton Piuff

Service No.

3

Address 70 Simonds Road

Lexington, Mass.

Location 70 Simonds Road

Kind of Pipe

Size 6"

Size of Main 8"

~~Repair - Renewal~~ - New Service

Com. 5-2-49

Location

Date	Material	Amount	Total	Date	Amount
Jan. 21, '49	Labor	72 81	72 81	Mar. 7, '49	115 00
	10% Overhead		7 28	May 11, '49	7 15
	46' - 6" Sewer Pipe @.265		12 19	May 14, '49	4 14
	Joint Compound		2 76		126 29
	Shovel 2 hrs. @7.00		14 00		
	Trucking 3 hrs. @.75		2 25	Bill sent 5-3-49	
	Patching 15 x 3		15 00		
11/16/81	<u>RENEWAL - BY JAMES REDMOND</u>		126 29		
	23' 6" P.V.C.			6-28-07	Respond + Rod Out IF
	1 4" Rubber Donut			JMOR	Needed (needs to be dug)
	1 Fernco Adaptor			11-25-96	Roots 51'
	Labor			5-29-89	Roots
				2-4-92	Roots & Rags
				11/25/96	JW Root at main + connection to house - AT
					main - Town Problems

# TOWN OF LEXINGTON—DEPT. OF PUBLIC WORKS

## SEWER DIVISION

DATE .....

NO. ....

The undersigned applies for the construction of a particular sewer connecting No. ....  
 Street and hereby agrees to comply with the Rules and Regulations governing the construction and use of Particular  
 Sewers, as now or at any future time established by the Board of Selectmen.


Am't of estimate \$.....

Am't Paid \$.....

..... Owner

Sketch of Service Here

**70**

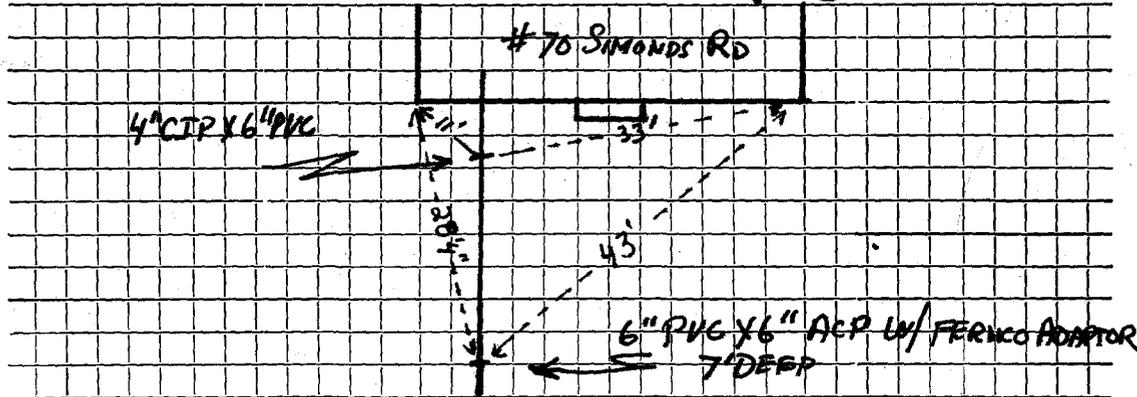

Connection made in ..... Street.

Work completed ..... 19..

Remarks: