

Name **Thomas Moon**

Service No.

Address **84 Simonds Road**

Lexington, Mass.

Location

Kind of Pipe **Con. June 14, 1948**

Size **6 "**

Size of Main **8 "**

Repair—Renewal—New Service

Location

Date	Material	Amount.	Total	Date	Amount
May 2, 1948	Labor	64 24	64 24	May 19 '48	Deposited 125.00
	10% Overhead		6 42	June 12 '48	Refunded 16.62
	48'-6" Sewer Pipe @.26		12 48		108.37
	2-6" Elbows @ 1.18		2 36		
	Joint Compound		2 88		
	Compressor 2 hrs. @ 1.75		3 50		
	Trucking 2 hrs. @.75		1 50		
	Patching 15 x 3		15 00		
			108 38		
	Labor				

TOWN OF LEXINGTON—DEPT. OF PUBLIC WORKS
SEWER DIVISION

DATE

NO.


The undersigned applies for the construction of a particular sewer connecting No.
Street and hereby agrees to comply with the Rules and Regulations governing the construction and use of Particular
Sewers, as now or at any future time established by the Board of Selectmen.

Am't of estimate \$.....

Am't Paid \$.....

..... Owner

Sketch of Service Here

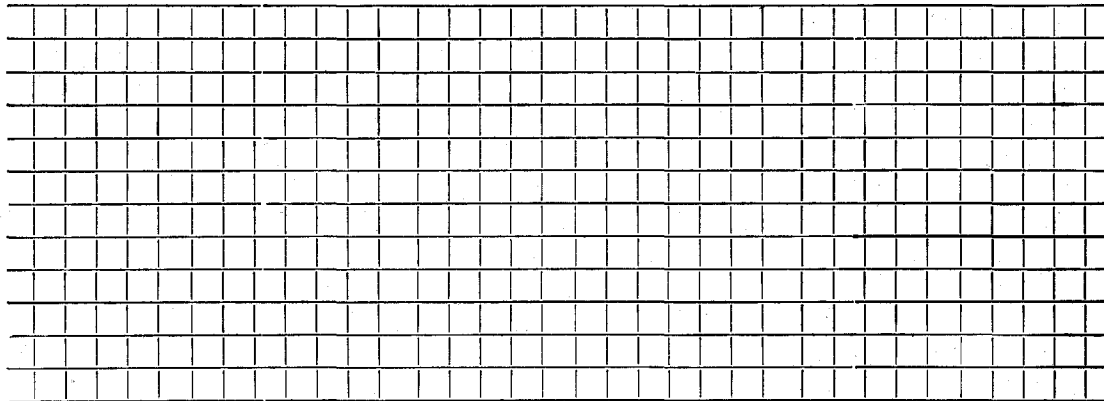

A large grid for sketching the service area. The grid consists of 14 columns and 14 rows of small squares, providing a space for drawing the sewer layout.

Connection made in Street.

Work completed 19..

Remarks: