

Name

Service No.

Address

87 Simonds Road

Location

Kind of Pipe

Size 6"

Size of Main 8"

Repair—Renewal—New Service

Location

Date

Material

Amount

Total

Date

Amount

12-9-97

86' 6" Sewer Pipe
1 6" Y Branch

Labor

TOWN OF LEXINGTON—DEPT. OF PUBLIC WORKS

SEWER DIVISION

DATE

NO.

The undersigned applies for the construction of a particular sewer connecting No.
 Street and hereby agrees to comply with the Rules and Regulations governing the construction and use of Particular
 Sewers, as now or at any future time established by the Board of Selectmen.

Am't of estimate \$.


Am't Paid \$.

Richard H. Gulch Owner

The layout and location of this sewer service connection is in accordance with my request and instructions to the Dept. of Public Works for the Town of Lexington. I appreciate that there are changes in alignment of pipe underground without accessible cleanouts, and I further assume all responsibility and any costs that may be involved due to stoppages.

Sketch of Service Here

87

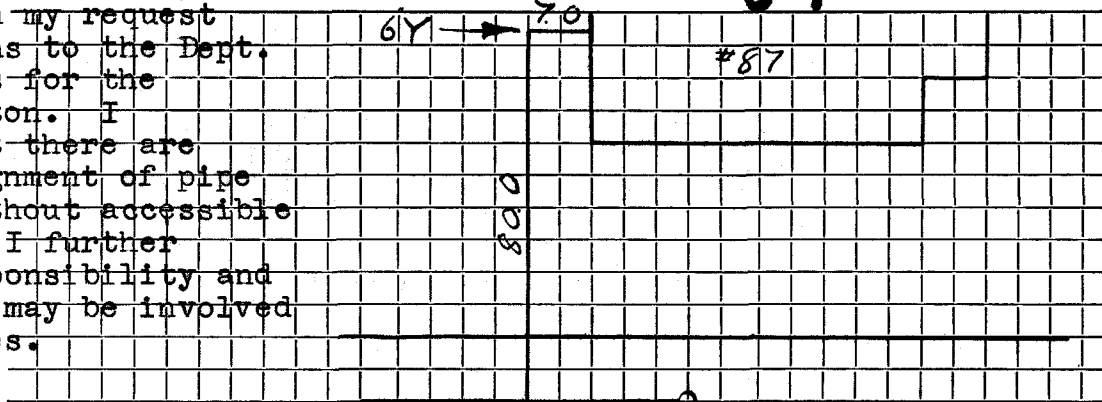

Connection made in Street.

Work completed 19..

Remarks: