




DATE Dec 1984

TOWN OF LEXINGTON — BOARD OF PUBLIC WORKS  
SEWER DIVISION

Sketch of Service Here **92**

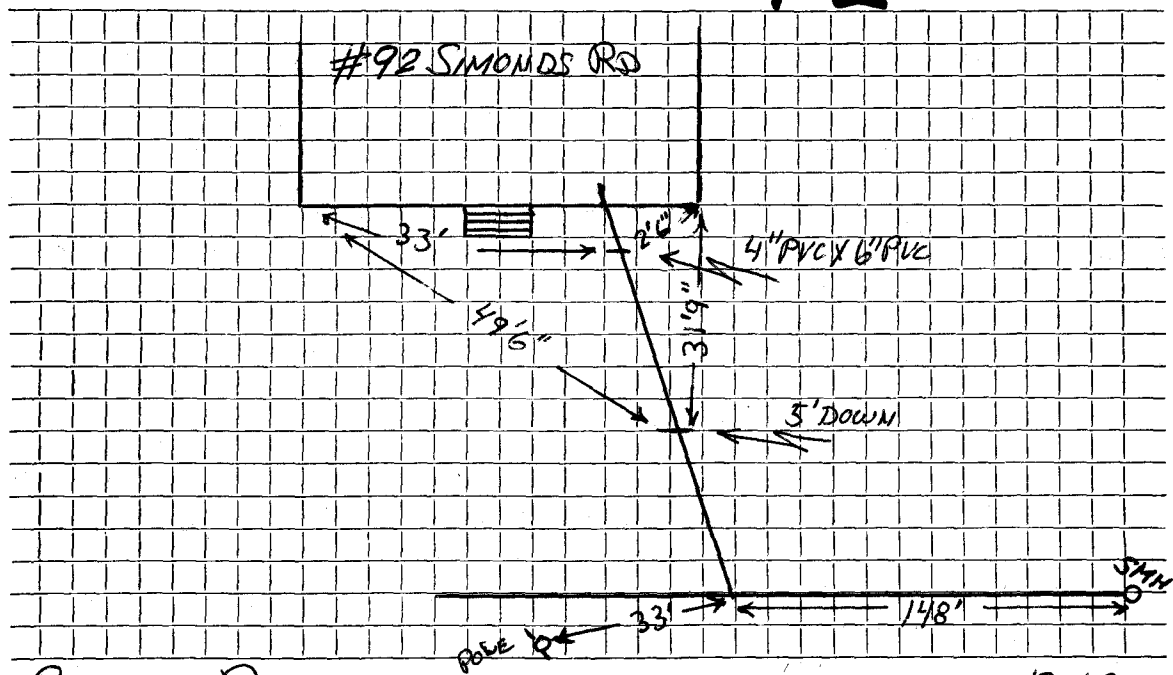

Connection made in SIMONDS RD Street. Work completed MARCH 19, 1985

Remarks: .....

.....