

Name Kenneth A. Foss

Service No. 106

Address 95 Simonds Road

Lexington

Location

Kind of Pipe

Size 6"

Size of Main 8"

~~Repair~~ ~~Renew~~ — New Service

COM. 11-3-52

Location

Date	Material	Amount	Total	Date	Amount
9/22/52	Labor	41 15		7-24-52	150 -
	10% Overhead	4 12	45 27	11-5-52	(12 45)
	58' - 5" transite pipe @ .55		31 90		137 55
	1 - 6" elbow		1 88		
	6 hr. Littlefield shovel		42 00		
	2 hr. trucking		1 50		
	patching 15 X 3		15 00		
			<u>137 55</u>		
	Labor				

**TOWN OF LEXINGTON—DEPT. OF PUBLIC WORKS**  
**SEWER DIVISION**

DATE.....

NO. ....

The undersigned applies for the construction of a particular sewer connecting No.....  
Street and hereby agrees to comply with the Rules and Regulations governing the construction and use of Particular  
Sewers, as now or at any future time established by the Board of Selectmen.


Am't of estimate \$.....

Am't Paid \$.....

..... Owner

---

**Sketch of Service Here**

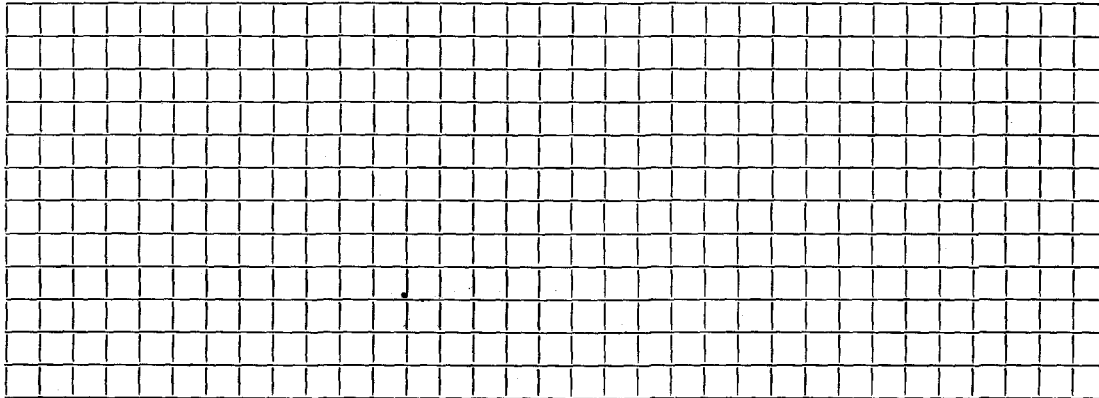

Connection made in..... Street.

Work completed.....19..

Remarks: