

Name Phyllis R. Nygard

Service No. 120

Address 1 SKYVIEW RD
1 Skyview Road

Location

Kind of Pipe A.C.

Size 6"

Size of Main 8"

Repair—Renewal—New Service Valeri #2346


Location NOV 19 1973

Date	Material	Amount	Total	Date	Amount
7/10/73	42'-6" A.C. @ \$8.90	\$ 373.80		9-17-73	Deposit
9/25/73	108' 6" Transite pipe				373.80

DATE _____

TOWN OF LEXINGTON — BOARD OF PUBLIC WORKS

SEWER DIVISION

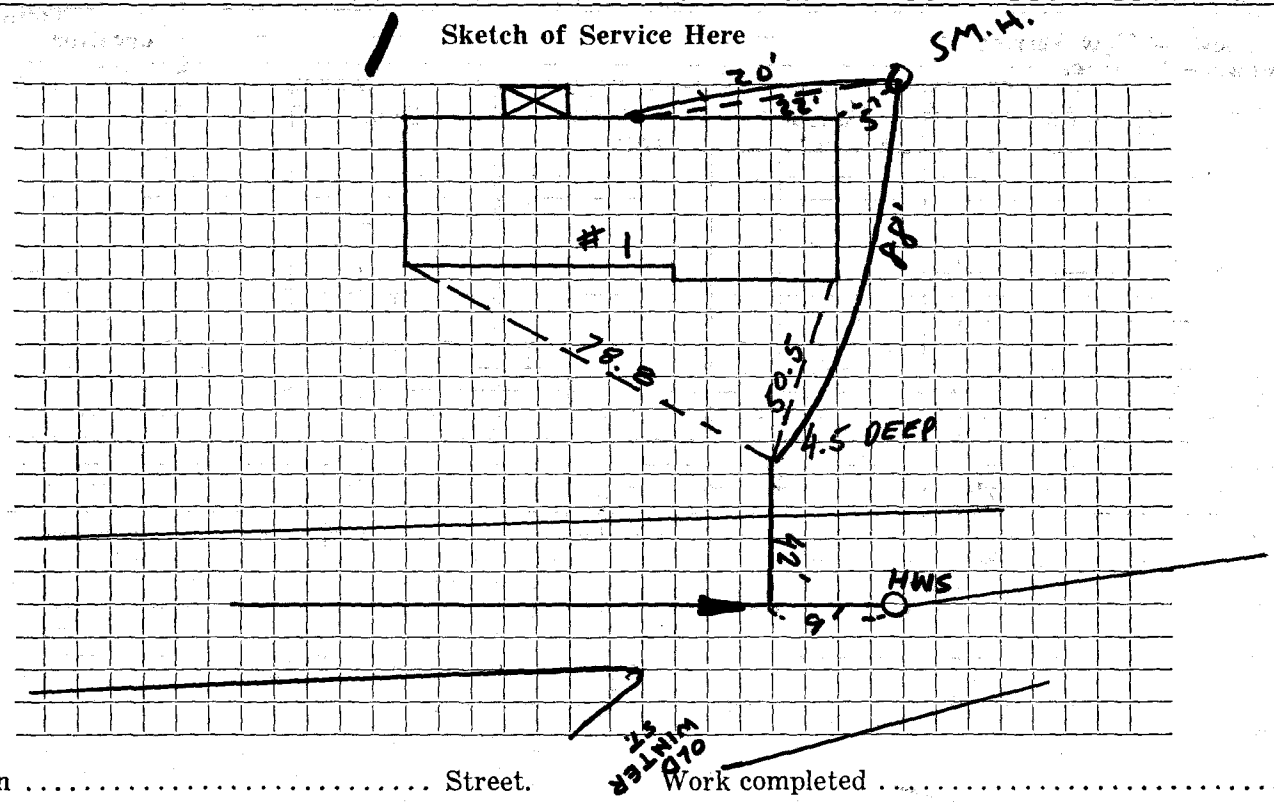

Connection made in Street. Work completed

Remarks:

.....

.....