


Sewer Service Tie Card
TOWN OF LEXINGTON
 MASSACHUSETTS

13 Skyview Road

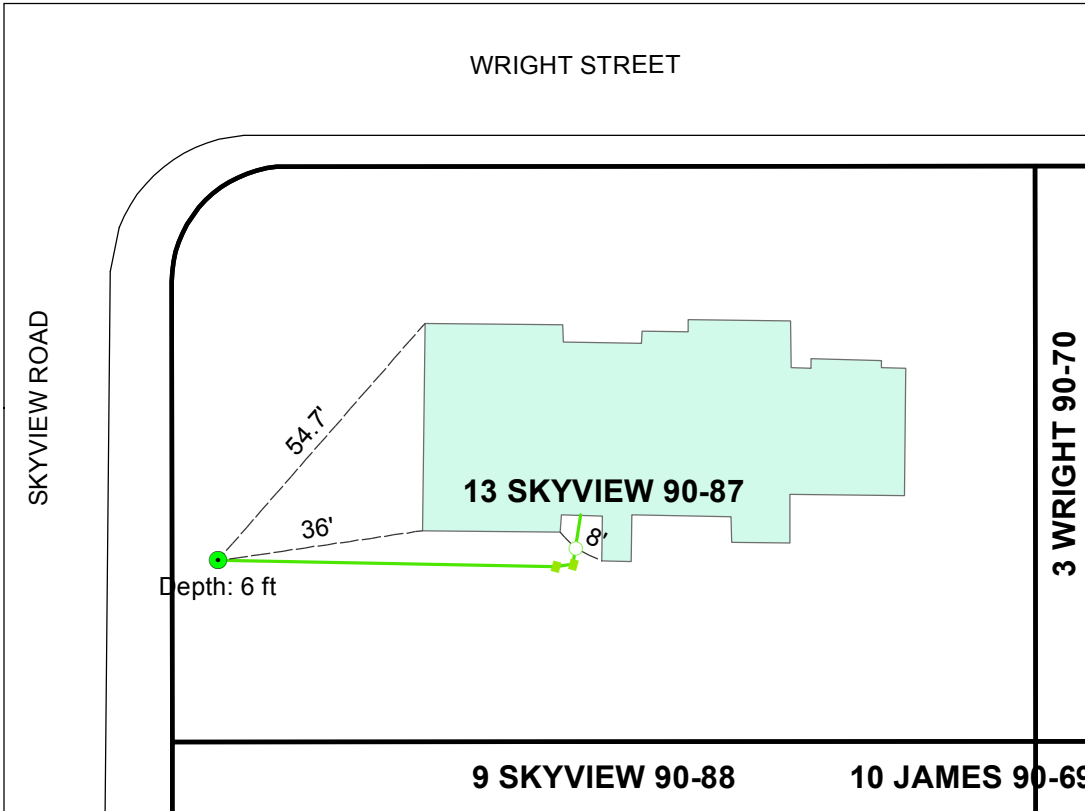

Address	Map and Lot	Contractor Name	Inspector
13 Skyview Road	90 - 87	J.W. Sullivan	D. Pavlik

Date	Material	Amount
September 24, 2013	6x6 AC to PVC Fern Co	Connected to existing stub
	6" PVC	60 Feet to 22 degree bend
	6" PVC	22 degree bend
	6" PVC	3 Feet to 22 degree bend
	6" PVC	22 degree bend
	6" PVC	Clean out
	6"x4" Fern Co.	Fern Co. at Clean Out

Type of work completed

New 6" PVC sewer service to house from old sewer stub. New house built - old house removed on existing lot.