


DATE December 2016

TOWN OF LEXINGTON — BOARD OF PUBLIC WORKS
SEWER DIVISION

Sketch of Service Here

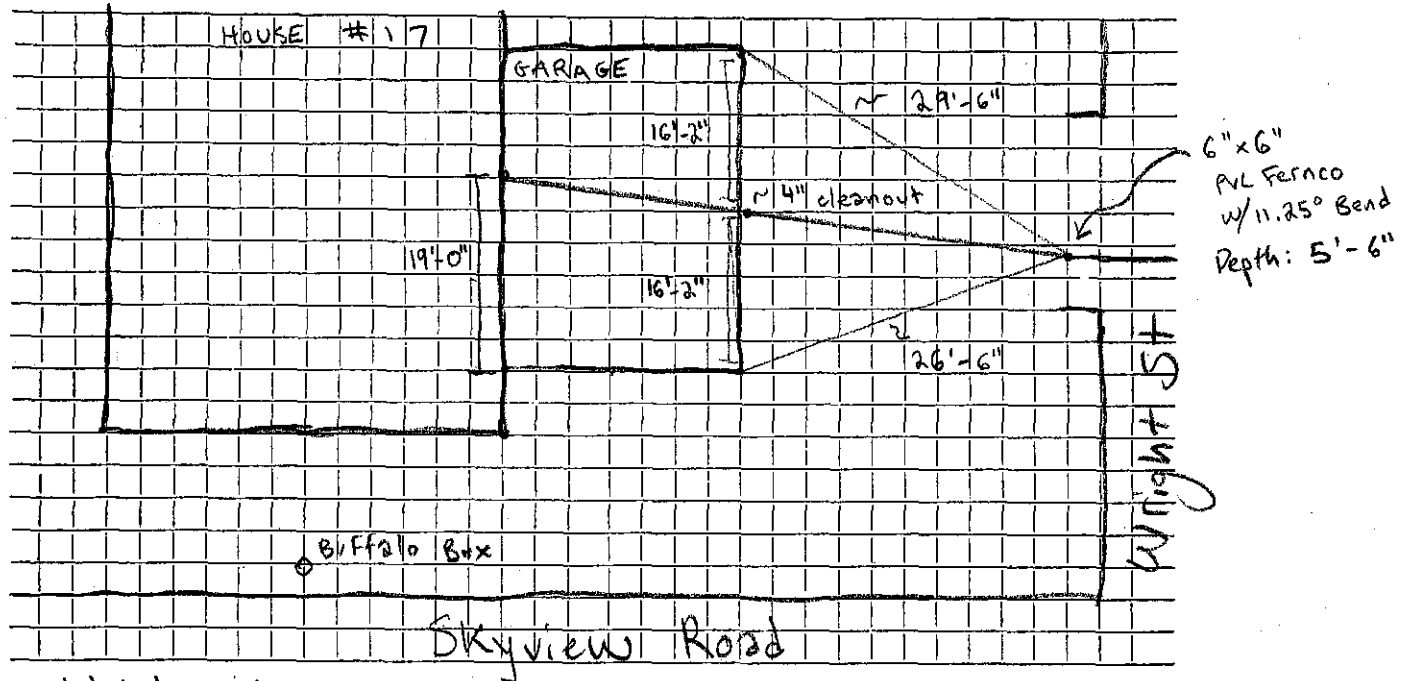

Connection made in Wright St Street. Work completed

Remarks: House is #17 Skyview Rd, sewer tie on Wright St.