

Name Charles Killilea

Service No. 95

Address 18 SKYVIEW RD.

Location

Kind of Pipe A.C.

Size 6"

Size of Main 8"

Repair—Renewal—New Service *Eng/c # 2334*

Location *OCT 25 1973*


| Date | Material | Amount | Total | Date | | Amount |
|---------|----------------------|-----------|-------|---------|---------|--------|
| 7/10/73 | 23'-6" A.C. @ \$8.90 | \$ 204.70 | | 8-23-73 | Deposit | 204 78 |
| | | | | | | |
| | | | | | | |
DATE _____

TOWN OF LEXINGTON — BOARD OF PUBLIC WORKS

SEWER DIVISION

Sketch of Service Here **18**

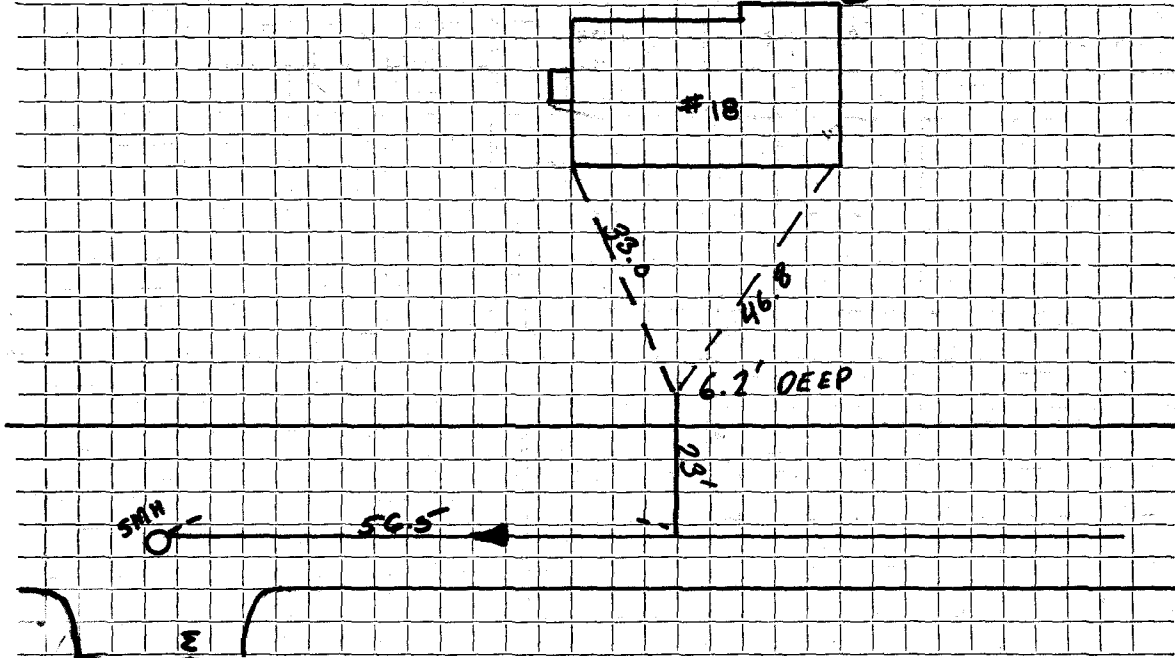

Connection made in Street. Work completed

Remarks:
.....
.....