

Name **Frederick Mitchel**

Service No. **53**

(75)

Address **21 SKYVIEW RD.**

Location

Kind of Pipe **A.C.**

Size **6"**

Size of Main **8"**

Repair—Renewal—New Service

Valeri #2711

Location


AUG 16 1976

Date		Material	Amount	Total	Date	Amount
7/10/73		22'-6" A.C. @ \$8.90	\$ 195. 80		6-6-75	<i>Deposit</i>
7/30/75	96'	6" Transite Pipe				195 80
	15'	4" Cast Iron Pipe				

DATE _____

TOWN OF LEXINGTON — BOARD OF PUBLIC WORKS

SEWER DIVISION

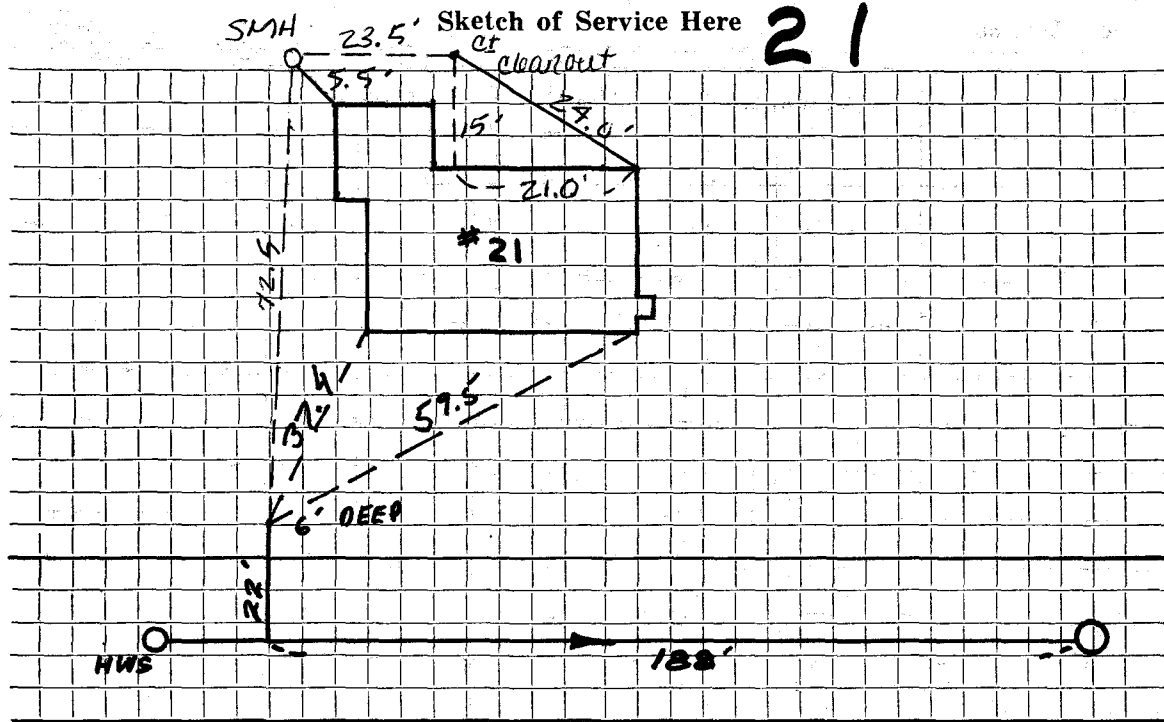

Connection made in ... SKYVIEW ... Street. Work completed ... 7-30-75 ...

Remarks: