




DATE \_\_\_\_\_

TOWN OF LEXINGTON — BOARD OF PUBLIC WORKS

SEWER DIVISION

Sketch of Service Here **25**

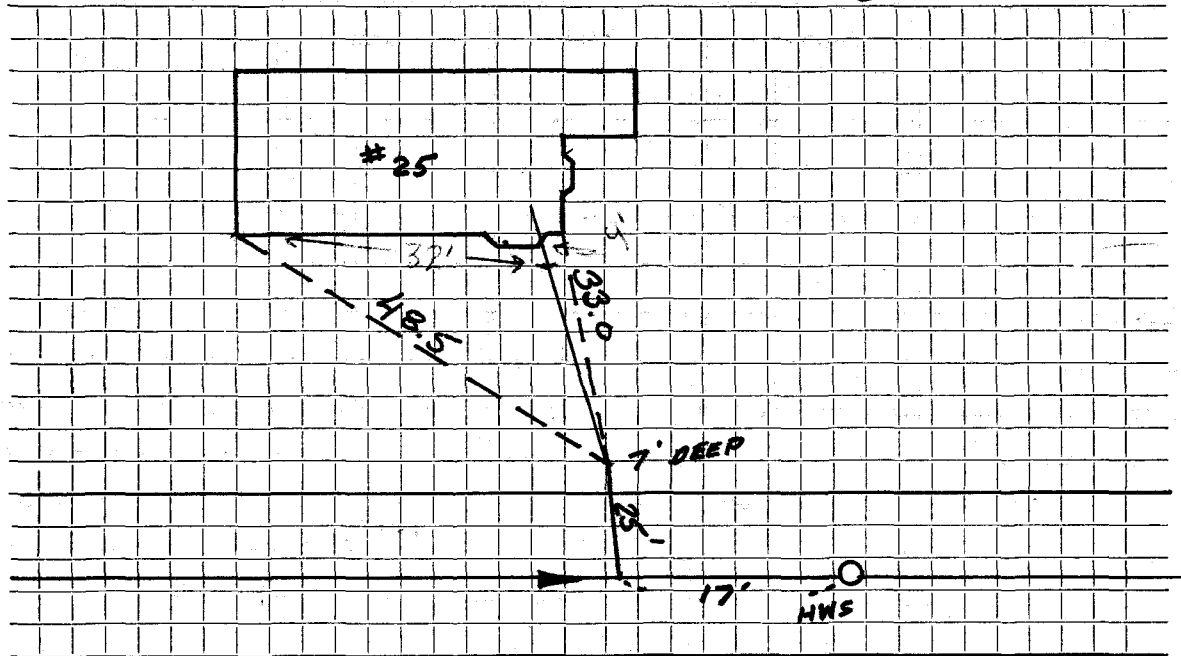

Connection made in SPYVIEW RD Street. Work completed 11-18-82

Remarks: .....

.....

.....