


DATE 9-12-90

TOWN OF LEXINGTON — BOARD OF PUBLIC WORKS
SEWER DIVISION

Sketch of Service Here **27**

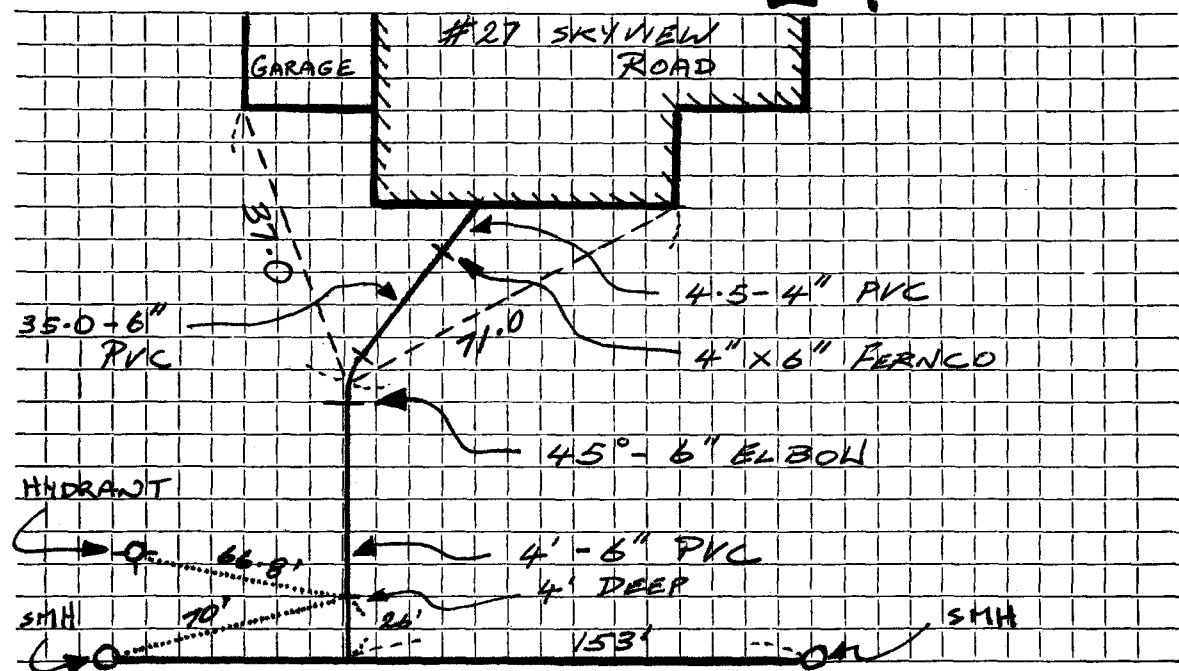

Connection made in SKYVIEW ROAD Street. Work completed

Remarks: