

Name

Service No.

Address 31 SKYVIEW RD. (VACANT LOT)

31 Skyview Road

Location

Kind of Pipe A.C.

Size 6"

Size of Main 8"

Repair—Renewal—New Service

Location

Date

Material

Amount

Total

Date

Amount


7/10/73

27'-6" A.C. @ \$8.90 \$ 240.30

DATE _____

TOWN OF LEXINGTON — BOARD OF PUBLIC WORKS
SEWER DIVISION

Sketch of Service Here

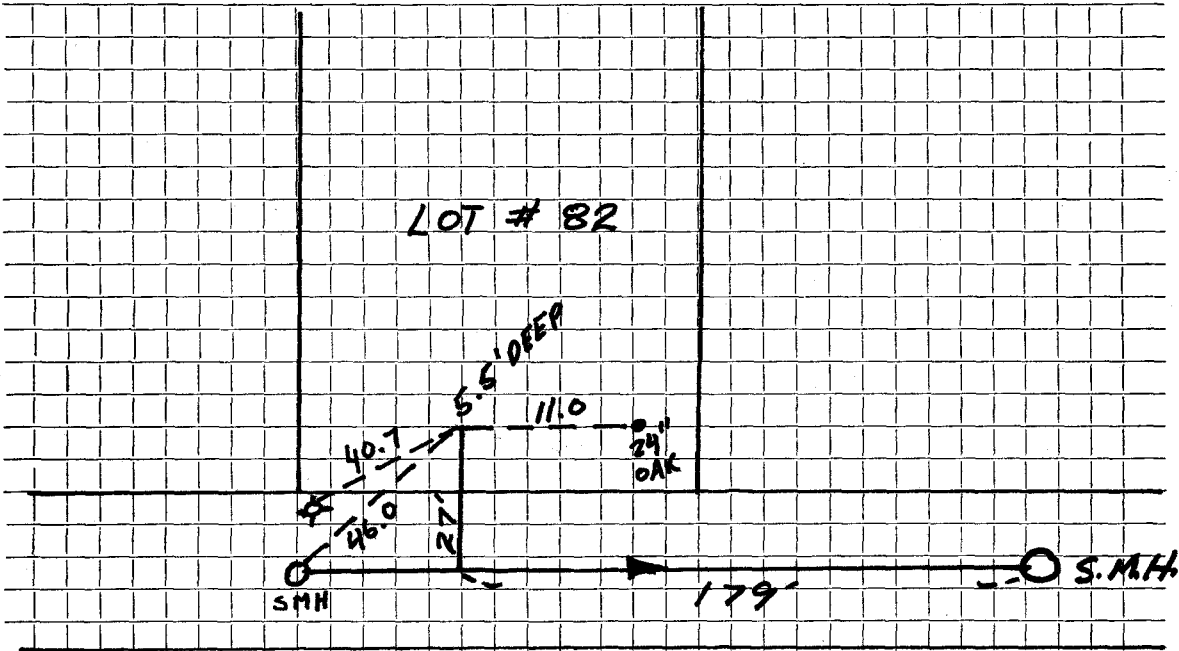

Connection made in Street. Work completed

Remarks:
.....
.....