

DATE _____


TOWN OF LEXINGTON — BOARD OF PUBLIC WORKS

SEWER DIVISION

32

Sketch of Service Here

#32 SKYVIEW RD

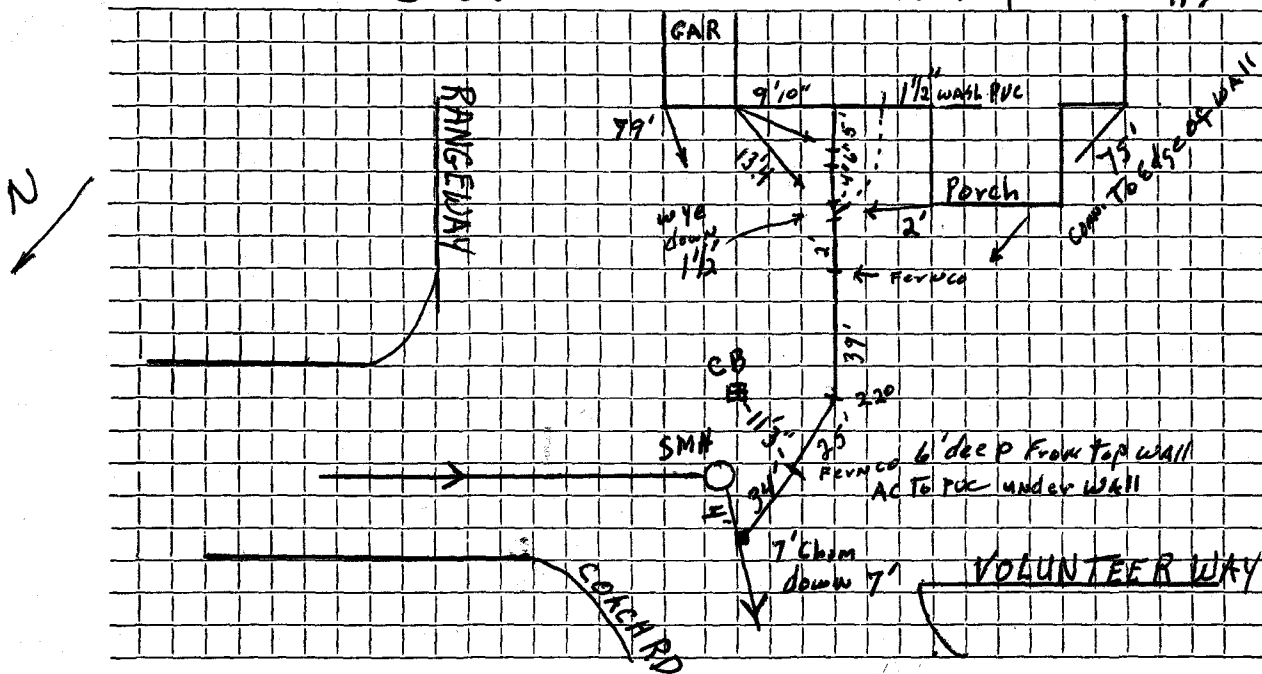

Connection made in Street Work completed

Remarks: Service comes out Rear of House (Original connection on main for this house NOT used.)

Ties 75' x 79' to connect Edge of Rd