

Name

Joanne MacDonald

Service No.

44

Address

33 Skyview Rd

33 Skyview Road

Location

AUG 6 1979

Kind of Pipe AC

Size 6"

Size of Main 8"

Repair—Renewal—New Service

Robert Trebino #3397

Location


Date	Material	Amount	Total	Date	Amount
9-17-75	37'-6" AC @	\$10.00 =	\$370.00	6-15-79	Deposit
6/21/79	26' 6" Transit Pipe				
10'	4" Cast Iron Pipe				

DATE _____

TOWN OF LEXINGTON — BOARD OF PUBLIC WORKS
SEWER DIVISION

Sketch of Service Here

33

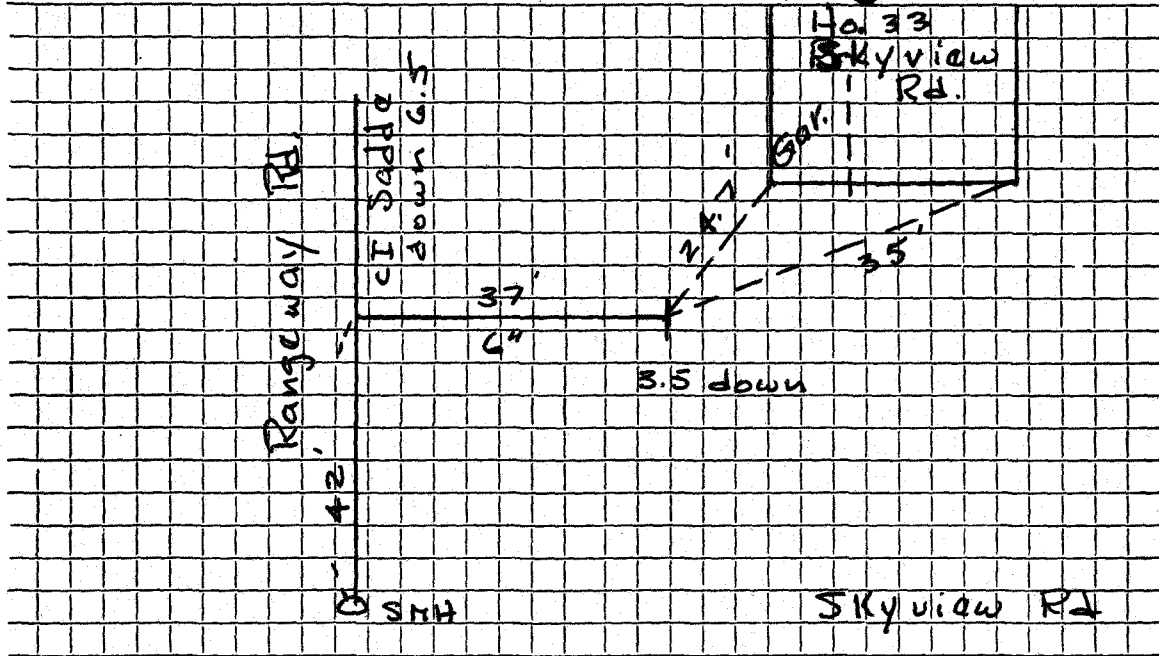

Connection made in Range way Rd. Street. Work completed

Remarks: Original Service on main for house not used 7-10-73