

Name James T. Tucker

Service No. 44

Address 35 Skyview Rd.

35 Skyview Road

Location

Kind of Pipe AC

Size 6"

Size of Main 8"

Applicant Pennsylvania-New Service Suburbanite #3768

Location

MAR 14 1983


Date	Material	Amount	Total	Date	Amount
9-16-75	17'-6" AC @	\$10.00	\$170.00	12-14-82	Deposit
12/20/82	25' P.V.C. Pipe				

DATE _____

TOWN OF LEXINGTON — BOARD OF PUBLIC WORKS

SEWER DIVISION

Sketch of Service Here **35**

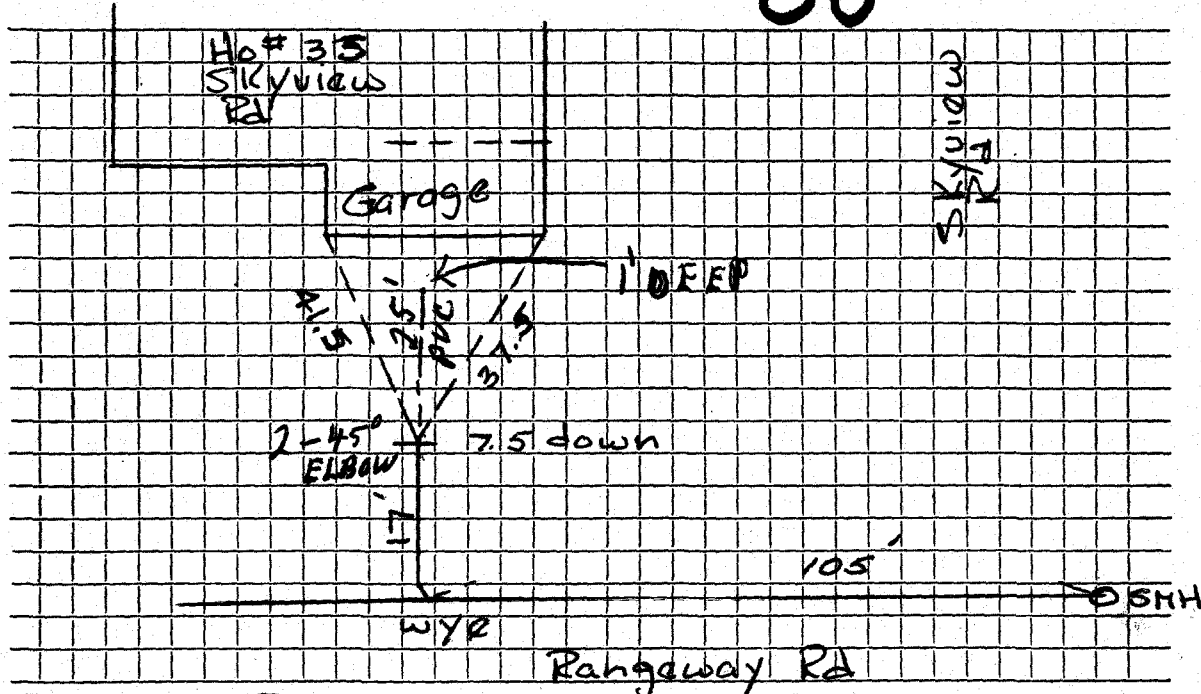

Connection made in Rangeway Rd Street. Work completed

Remarks:
.....
.....