




DATE 1-19-2018

TOWN OF LEXINGTON — BOARD OF PUBLIC WORKS  
SEWER DIVISION

Sketch of Service Here

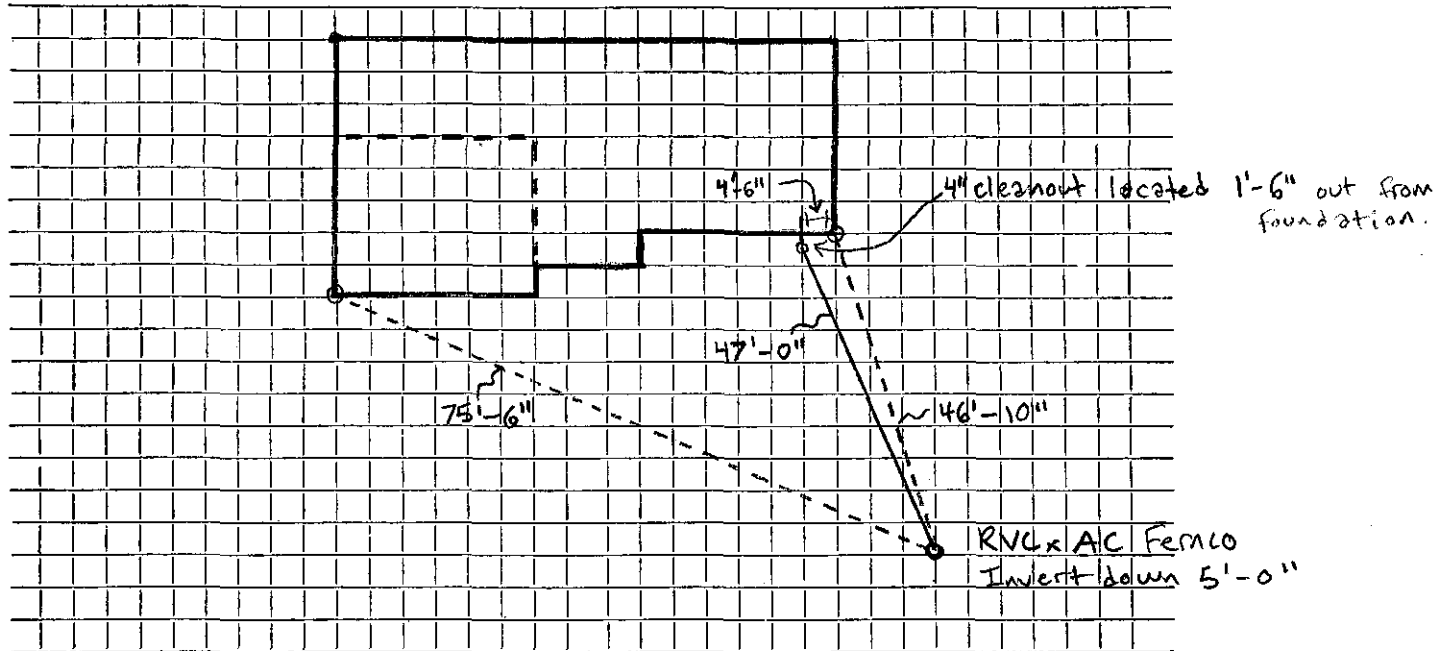

Connection made in 9 Skyview Road Street. Work completed .....

Remarks: .....