




DATE 5/20/96

TOWN OF LEXINGTON — BOARD OF PUBLIC WORKS  
SEWER DIVISION

Sketch of Service Here 19

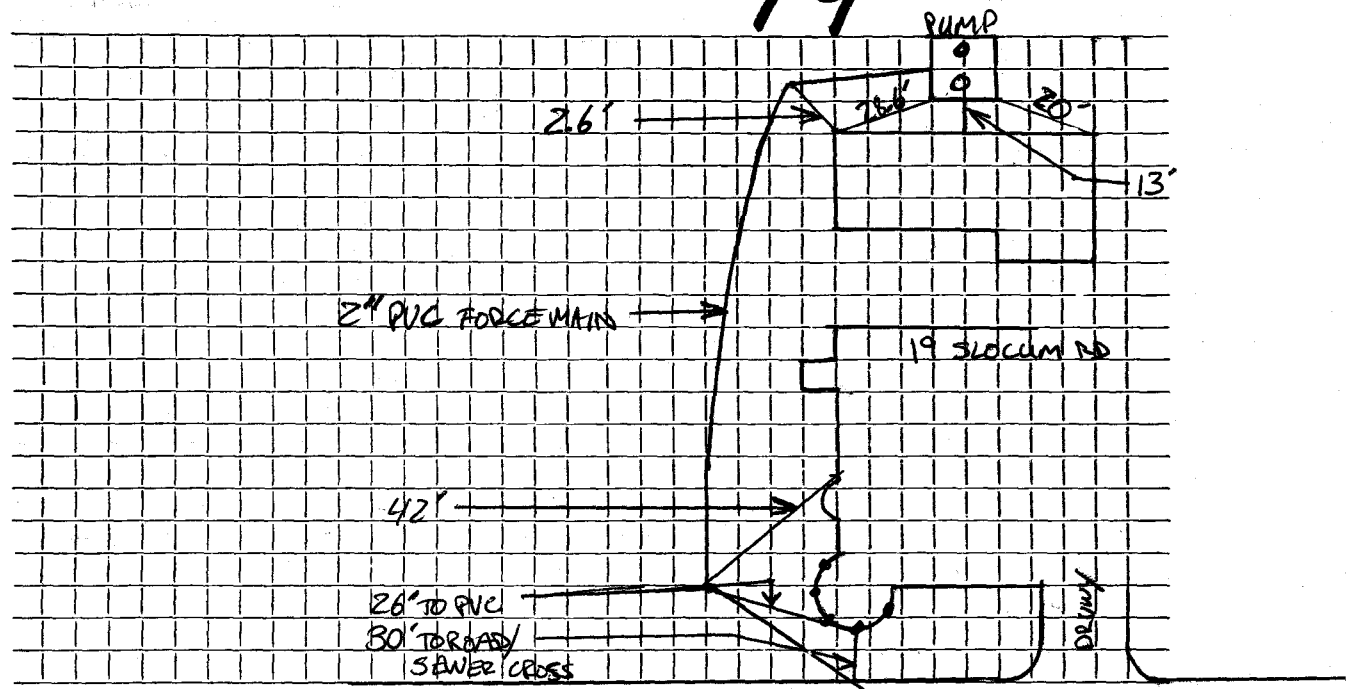

Connection made in ..... Street. Work completed ...  ..... EXIST. SEWER

Remarks: .....  
.....  
.....