

Name

Service No.

Address

20 Slocum Road

Location

Kind of Pipe

Size 6"

Size of Main 8"

Repair—Renewal—New Service

Location


| Date | Material | Amount | Total | Date | Amount |
|--------|-----------------|--------|-------|----------|----------------------------|
| 6-2-93 | | | | | |
| | 3' 4" C.I. Pipe | | | | |
| | 39' 4" P.V.C. | | | | |
| | 12' 6" P.V.C. | | | | |
| | 1 4"x4" Fernco | | | | |
| | 1 4"x6" Fernco | | | | |
| | 1 6"x6" Fernco | | | | |
| | | | | | |
| | | | | | |
| | | | | 12-28-92 | ROOTS 46' OUT OWNERS PROP. |
| | | | | 8-12-74 | ROOTS |

DATE _____

TOWN OF LEXINGTON — BOARD OF PUBLIC WORKS

SEWER DIVISION

Sketch of Service Here **20**

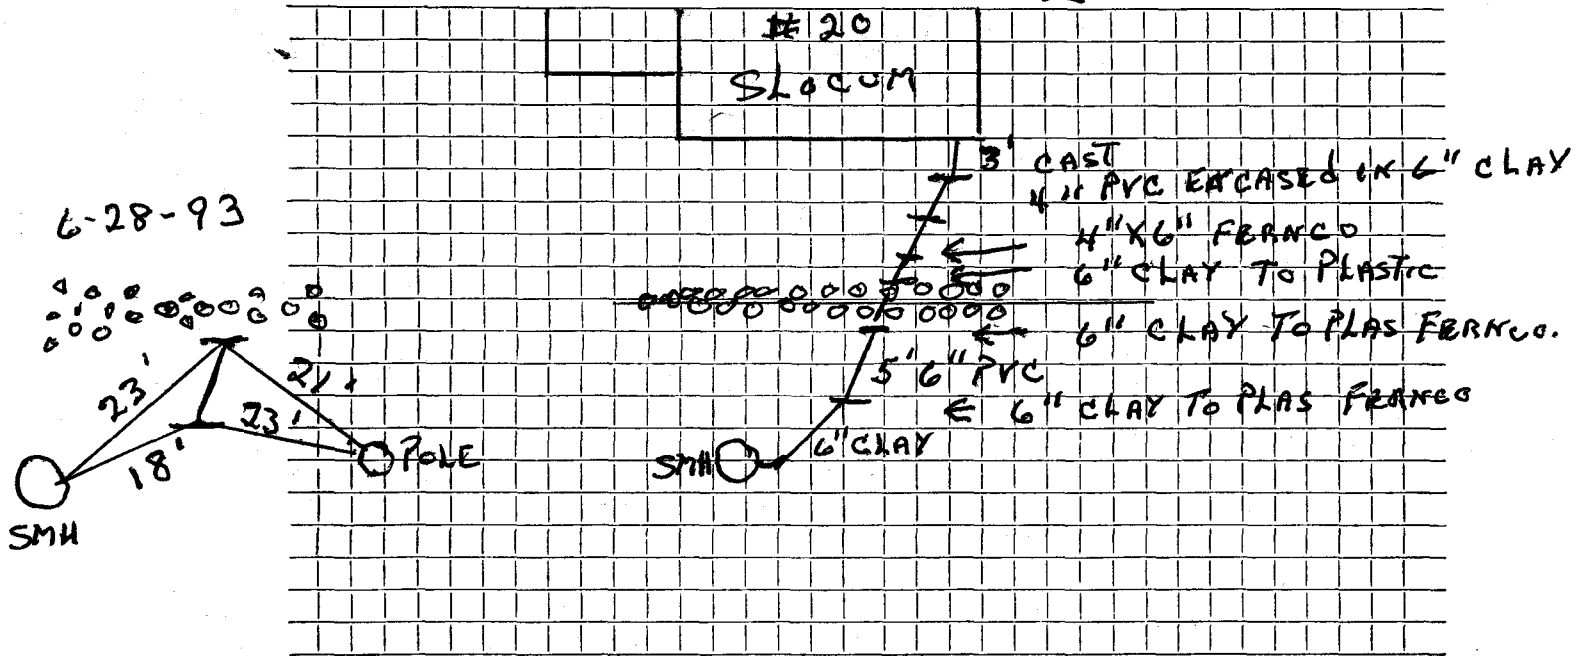

Connection made in Street. Work completed

Remarks: Original Service 10-15-51