

Name

Service No.

Address #21 Slocum Rd.

21 Slocum Road

Location

Kind of Pipe

Size 6"

Size of Main 8"

Repair—Renewal—New Service

Location

Date

Material

Amount

Total

Date


Amount

DATE _____

TOWN OF LEXINGTON — BOARD OF PUBLIC WORKS

SEWER DIVISION

Sketch of Service Here

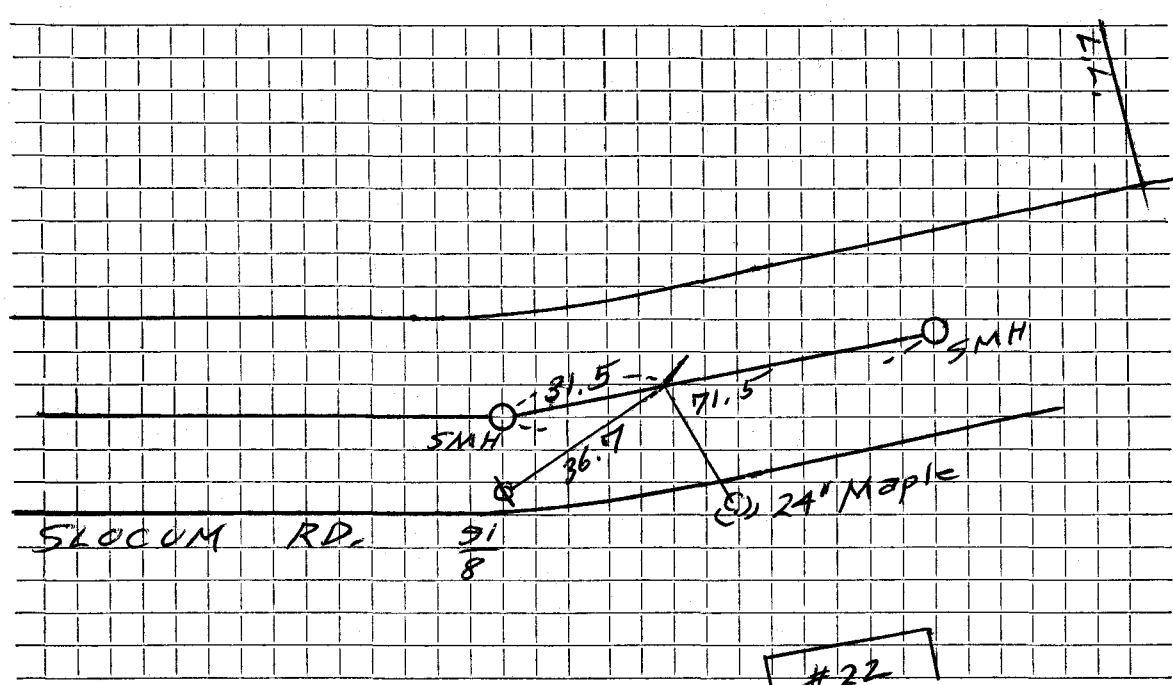

#19

#22

Connection made in Street. Work completed

Remarks:
.....
.....