

Name William Krag

Service No. 44

Address 22 Slocum Road

22 Slocum Road

Location

Kind of Pipe

Size 6"

Size of Main 8"

Repaired ~~Renewal~~ - New Service W.O. #7934

Location Comm 8-26-63


Date	Material	Amount	Total	Date	Amount	
6-10-63	Labor	109.14		8-15-63	Deposit	250.00
6-11-63	"	32.59	141.73	8-26-63	Paid by WTC #35	7.00
	10% O.H.	14.17	155.90			257.00
	45' 6" Transite pipe @88		39.60			
	6 yds. Loam @3.00		18.00			
	15 x 3 Patch		15.00			
	3 hrs. Town Shovel @6.50		19.50			
	3 hrs. Trucking @3.00		9.00			
			257.00			

DATE _____

TOWN OF LEXINGTON — BOARD OF PUBLIC WORKS

SEWER DIVISION

Sketch of Service Here **22**

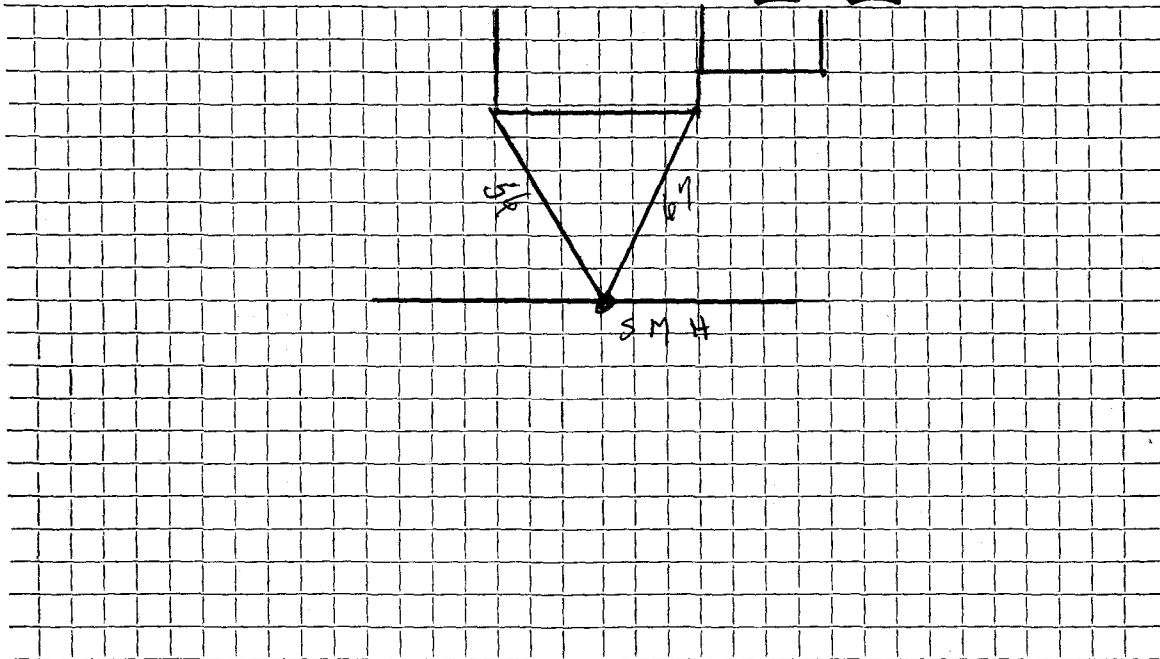

Connection made in Street. Work completed

Remarks:
.....
.....