

Name **Water Black**

Service No. **10 907**

Address **19 Highland Ave.**

*Arnold P. Beverage*

#4076

**8 Slocum Road**

Location **Alton Beverage, Slocum Road**

Kind of Pipe

Size **6"**

Size of Main **8"**

~~Renewal~~ **Renewal—New Service**

Location

Date	Material	Amount	Total	Date	Amount
8/25/29	47' 6" Sewer Pipe @.30	14 10			
<i>P.S. 7-29 for 15.98</i>	Sulphur & Jute	<u>1 88</u>	\$15 98	9-23-33	Cash 15 98
	Time on water slip				
	Labor			<i>A.R. 1-31-30</i> <i>A.R. 10-1-30</i> <i>A.P. 3-2-31</i> <i>A.P. 7-16-31</i> <i>12-26-31</i> <i>A.R. 4-26-33</i>	

Hidley Press, Inc., Lexington

TOWN OF LEXINGTON—BOARD OF PUBLIC WORKS

SEWER DIVISION

DATE 4/18/29

NO. Stoum Rd.

The undersigned applies for the construction of a particular sewer connecting No. Stoum Rd. Street and hereby agrees to comply with the Rules and Regulations governing the construction and use of Particular Sewers, as now or at any future time established by the Board of Selectmen.


Am't. of Estimate \$ \_\_\_\_\_

Am't. Paid \$ \_\_\_\_\_

W. Black Bell.

Attn Beverage Owner

Sketch of Service Here

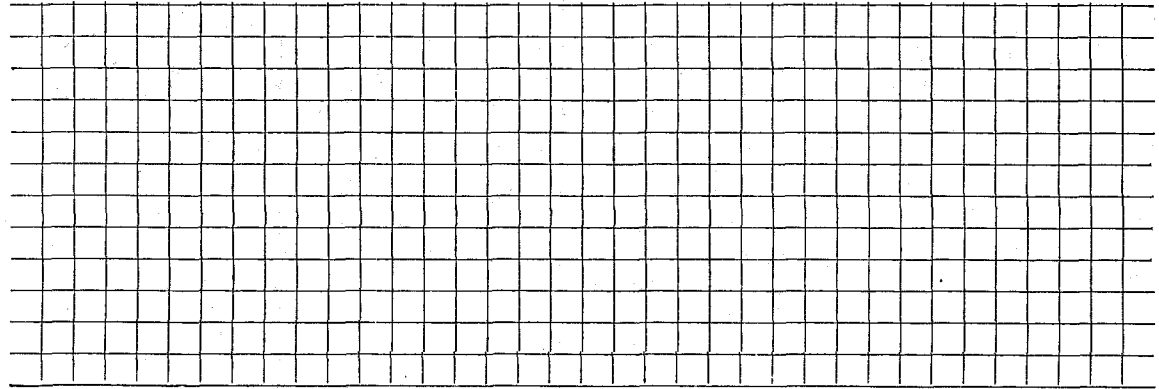

Connection made in \_\_\_\_\_ Street.

Work completed \_\_\_\_\_ 19

Remarks:

Sund W. Black