

Name Leonard J. Colwell

Service No. 161 (1956)

Address 10 Smith Avenue

10 Smith Ave.

Location

Comm. 7/25/57

Kind of Pipe

Size 6"

Size of Main 8"

~~Repair/Reconnect~~ - New Service

Location

Date	Material	Amount	Total	Date	Amount
11/13/56	Labor	39 37		10-29-56	Deposit \$ 200 00
11/14/56	"	10 40		7/25/57	Refund 1 17
		49 77			\$ 198 83
	10% overhead	4 98	54 75		RENEWAL W.O. #1979
	66' - 6" Sewer pipe @ .435		28 71	6/14/83	1 6" x 10' Transite pipe
	Joint compound		3 96	1	6" x 1' Transite pipe
	10 2/3 hrs. Littlefield Shovel			2	6" Transite to Clay Fernco Adapt.
	@ 8.50		90 66	1	6" x 11 ^o Transite Bend
	1 hr. Trucking		75		Patch 11' x 17'
	20x3 Patching		20 00		
			198 83		
	Labor				
				3-6-67	SLUDGE
				9-28-92	ROOTS 61# IN THE STREET

TOWN OF LEXINGTON—DEPT. OF PUBLIC WORKS
SEWER DIVISION

DATE

NO.

The undersigned applies for the construction of a particular sewer connecting No.
 Street and hereby agrees to comply with the Rules and Regulations governing the construction and use of Particular
 Sewers, as now or at any future time established by the Board of Selectmen.


Am't of estimate \$.

Am't Paid \$.

..... Owner

Sketch of Service Here

10

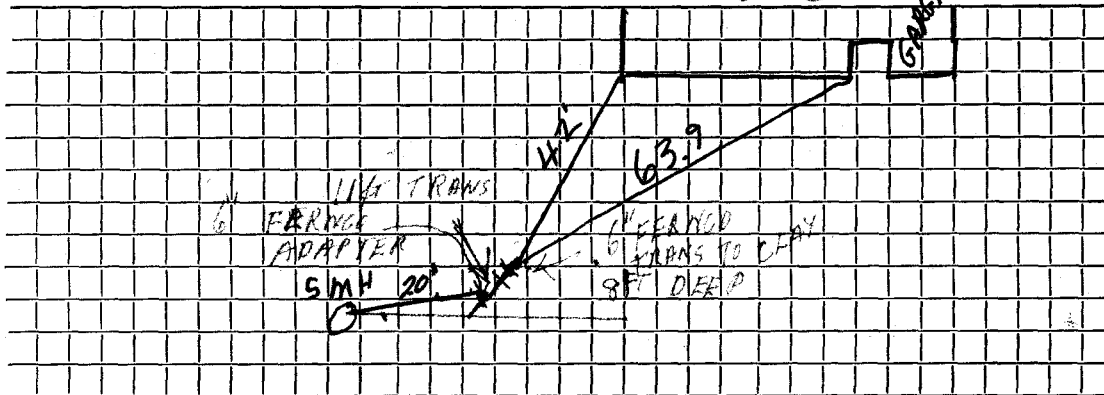

Connection made in Street. Work completed 19..

Remarks: *THE WATER IS 4'2" DEEP AT MAIN 6 1/2' DEEP AT CURB*
THE SEWER IS 8 FT DEEP UNDER THE WATER