


DATE _____

TOWN OF LEXINGTON — BOARD OF PUBLIC WORKS

SEWER DIVISION

Sketch of Service Here //

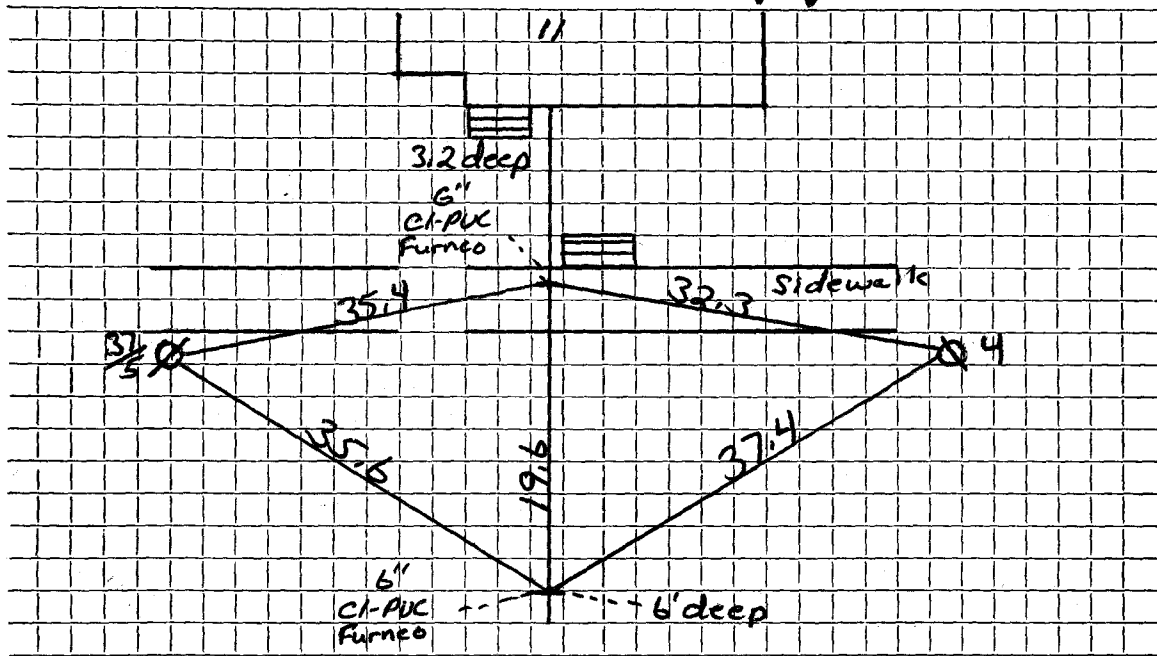

Connection made in Street. Work completed 9-3-91

Remarks: ..Sewer.. Runs.. under.. Gas..... Furnco. In street. Is.. Right under... 3/4" Cor.p...
..on.. Water.. Main... Digan LEFT Side Facing house. IF needed.....
Original Service 9-23-30 (46'-6" Sewer Pipe, 1-6" Elbow, 1-6" - 1/8" Bend)