

TOWN OF LEXINGTON—BOARD OF PUBLIC WORKS
SEWER DIVISION

DATE May 13, 1929

NO. _____
Lat 54 Smith Ave.


The undersigned applies for the construction of a particular sewer connecting No. 54 Smith Ave. Street and hereby agrees to comply with the Rules and Regulations governing the construction and use of Particular Sewers, as now or at any future time established by the Board of Selectmen.

Am't. of Estimate \$ _____

Am't. Paid \$ _____

Robert Smith
W. W. Robbins Owner

Sketch of Service Here

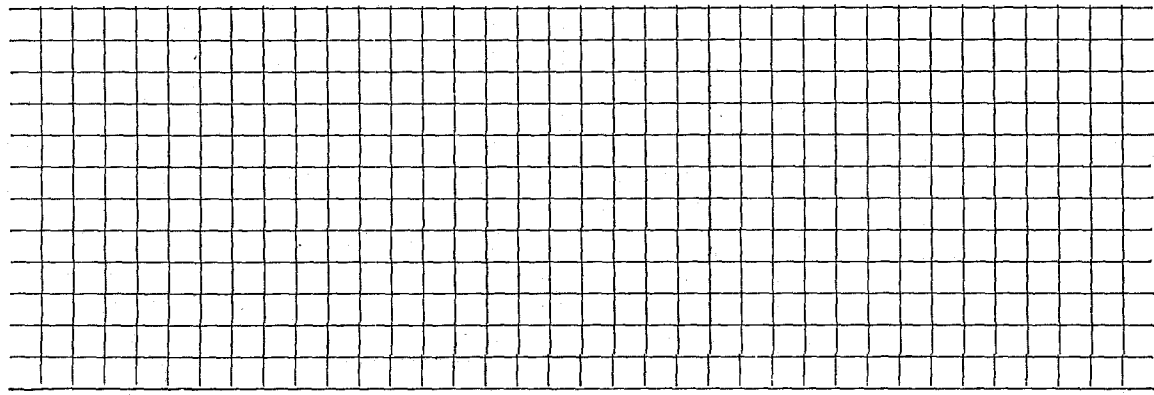

Connection made in _____ Street.

Work completed _____ 19

Remarks: