




DATE 11/4/92

TOWN OF LEXINGTON — BOARD OF PUBLIC WORKS  
SEWER DIVISION

Sketch of Service Here **13**

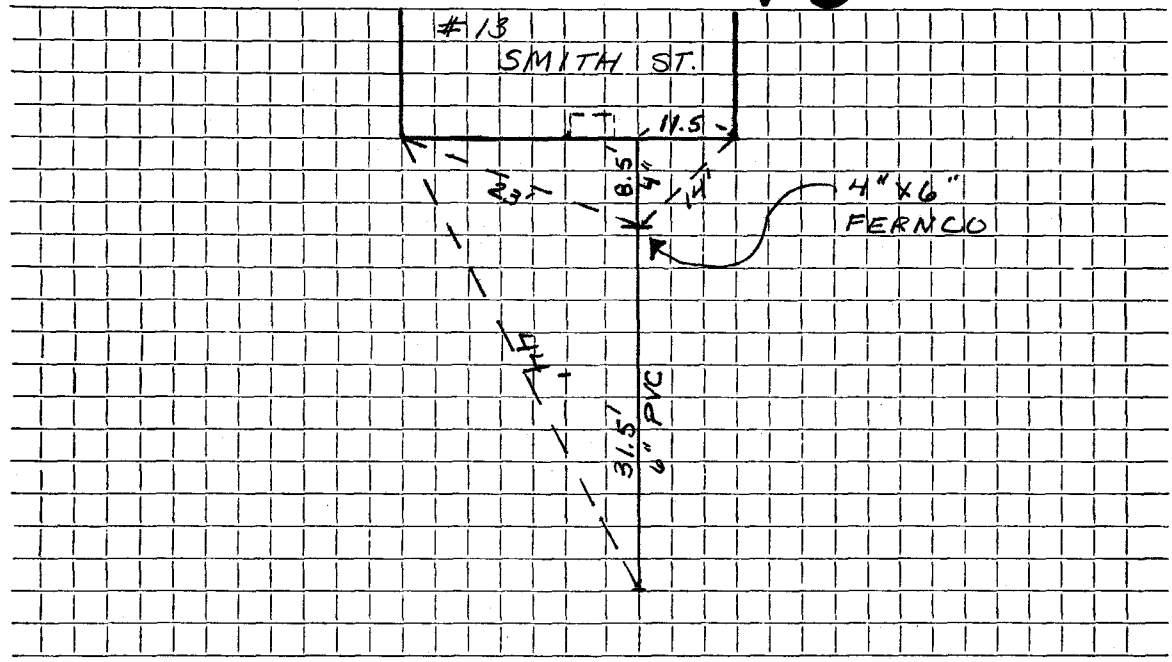

Connection made in ..... SMITH ..... Street. Work completed BY: BRUCE MCKEE .....  
Remarks: .. GAS .. SERVICE .. SET .. 1.5' .. OVER .. SEWER .. 1\" .. COPPER ..  
..... SERVICE .. SET .. 4\" .. OVER .. SEWER ..  
Original Service 11-14-31 53'-6\" Sewer Pipe, 10'-4\" C.I. Pipe ..