




DATE \_\_\_\_\_

TOWN OF LEXINGTON — BOARD OF PUBLIC WORKS  
SEWER DIVISION

Sketch of Service Here **17**

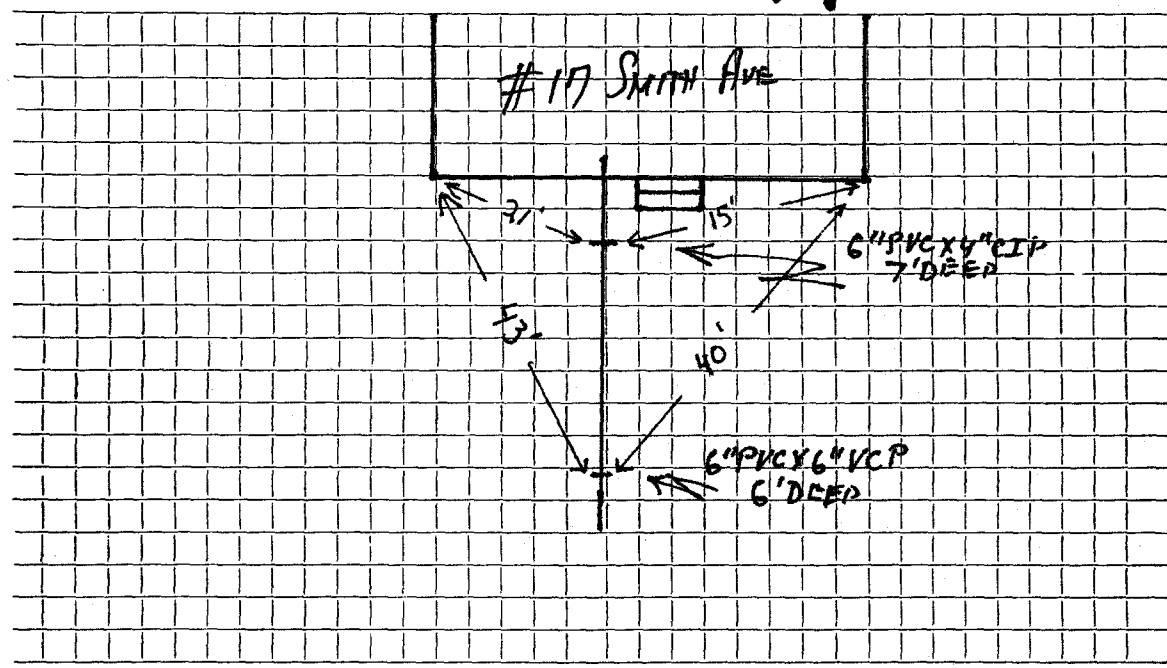

Connection made in SMITH AVE Street. Work completed .....

Remarks: NOTE: GAS-WATER-SEWER IN SAME TRENCH

Original Service 7-29-29 (50'-6" Sewer Pipe, 1-1/8" Bend.)