

Name James R. Smith

Service No. 55 724

Address 154 Highland Avenue

18 Smith Ave. Location Lot #49, Smith Ave. #18

Kind of Pipe

Size 6"

Size of Main 8"

~~Repair~~—New Service

Location

Date	Material	Amount	Total	Date	Amount
P.O. 1-1830 for 82.85	55 6" Sewer Pipe @.30	16 50			
	1 6" Bend	70			
	Sulphur & Jute	2 20	19 40	Dec. 8 1930 - Cash	82 85
1/13	96 Hrs. Labor @.55	52 80			
	4 " " @.60	2 40	55 20		
	15% Overhead		8 28		
			82 88		
	Labor				

Hadley Press, Inc., Lexington

TOWN OF LEXINGTON—BOARD OF PUBLIC WORKS
SEWER DIVISION

DATE _____

NO. _____


The undersigned applies for the construction of a particular sewer connecting No. _____ Street and hereby agrees to comply with the Rules and Regulations governing the construction and use of Particular Sewers, as now or at any future time established by the Board of Selectmen.

Am't. of Estimate \$ _____

Am't. Paid \$ _____

_____ Owner

Sketch of Service Here

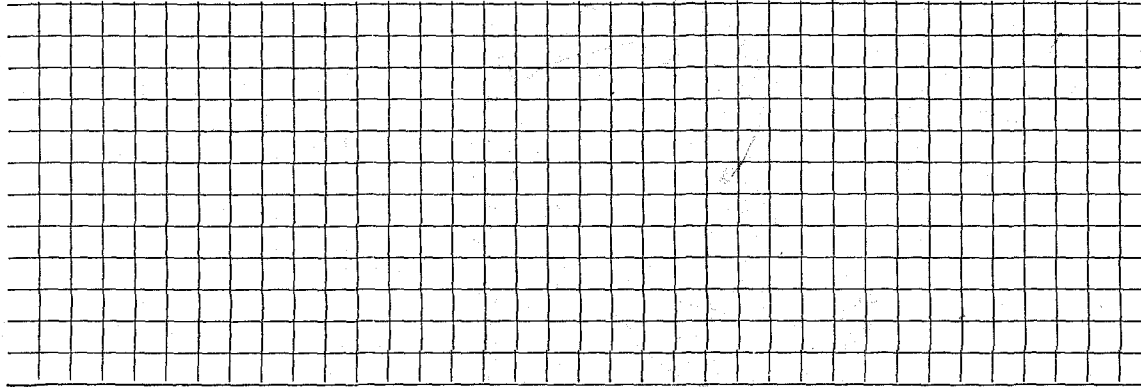

Connection made in _____ Street.

Work completed _____ 19

Remarks: