

Name

Robbins & Smith, Inc.

Service No.

96914

Address

4 College Circle, Somerville

5 Smith Ave.

Location

Lot #41, Smith Ave.

Kind of Pipe

Size 6"

Size of Main 8"

~~Repair-Renewal~~ New Service

Location

Date	Material	Amount	Total	Date	Amount
2-11-27-28 for 17-10	45' 6" Clay Pipe @ .30	13 50			
	1 6" y	1 05			
	Sulphur & Jute	1 80			
	Trucking	75	17 10	Dec. 15 1925- Cash	17 10
	Labor on water slip				
	Labor				

*4' off hill to go in
cellar dug.*

TOWN OF LEXINGTON—BOARD OF PUBLIC WORKS

SEWER DIVISION

DATE November 5, 1928

NO. _____


The undersigned applies for the construction of a particular sewer connecting No. Lot 41 - Smith Ave. Street and hereby agrees to comply with the Rules and Regulations governing the construction and use of Particular Sewers, as now or at any future time established by the Board of Selectmen.

Am't. of Estimate \$ _____

Am't. Paid \$ _____

Robbins Smith
by W. N. Rottier Owner

Sketch of Service Here

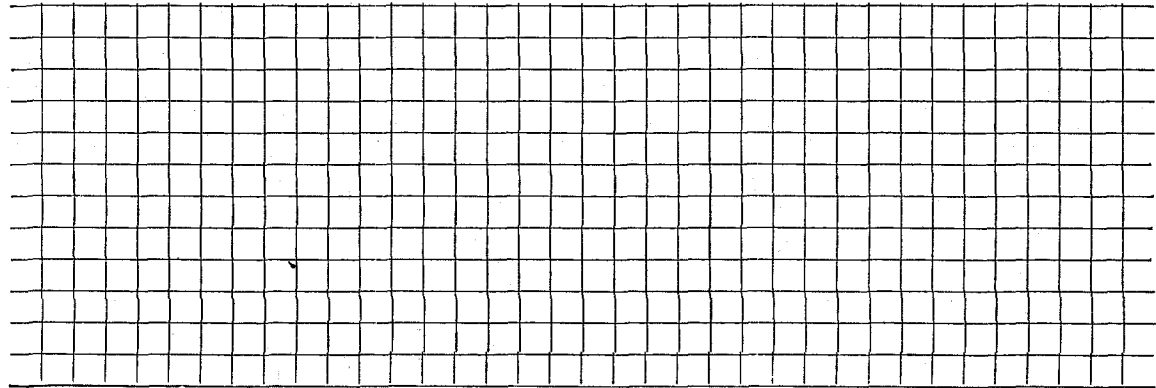

Connection made in _____ Street.

Work completed _____ 19

Remarks: