

Name Robbins & Smith, Inc.

Service No. 13 915

Address ~~4 College Circle, Somerville~~

7 Smith Ave. Location

#7
Lab 47 Smith Ave.

Kind of Pipe

Size 6"

Size of Main 8"

~~Repair/Renewal~~ - New Service

Location

Date	Material	Amount	Total	Date	Amount
6/5/29	50 6" Sewer Pipe @ .30	15 00			
6-25-29 for 17.75	Sulphur & Jute	2 00			
	Trucking	<u>75</u>	17 75	Aug 9-29 Cash	17 75
	Labor on water slip				
			✓		
	Labor				

Hadley Press, Inc., Lexington

TOWN OF LEXINGTON—BOARD OF PUBLIC WORKS

SEWER DIVISION

DATE May 13, 1929

NO. _____


The undersigned applies for the construction of a particular sewer connecting No. ^{Lot} 42 Smith Ave. Street and hereby agrees to comply with the Rules and Regulations governing the construction and use of Particular Sewers, as now or at any future time established by the Board of Selectmen.

Am't. of Estimate \$ _____

Am't. Paid \$ _____

Robbins & Smith Inc.
M. M. Robbins Owner

Sketch of Service Here

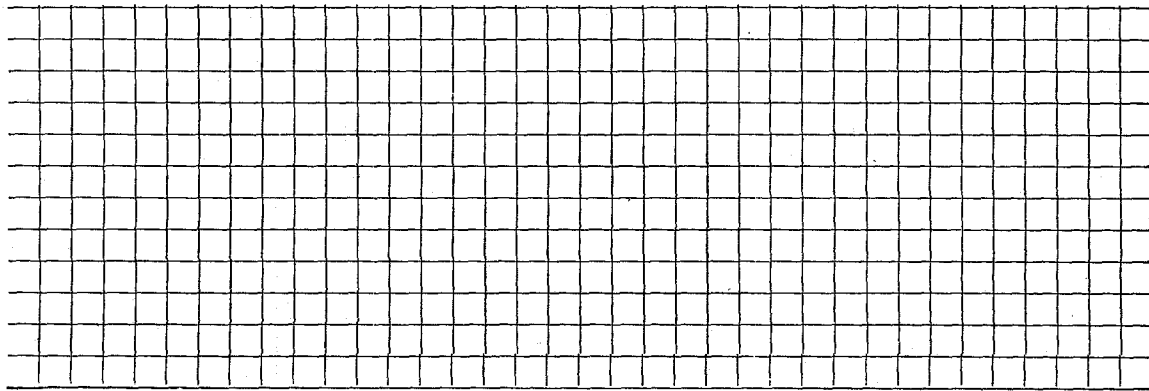

Connection made in _____ Street.

Work completed _____ 19

Remarks: