

Name

Burke & Chambers

Service No.

27 916

Address

~~Mr. Howard Chambers, 33 Bowdin St., Arlington~~

Lot #43

#9 Smith Ave.

Location

Lot #43, Smith Ave.

Kind of Pipe

Size 6"

Size of Main 8"

~~Repair~~ - New Service

Location

Date	Material	Amount	Total	Date	Amount
72-25	46' 6" Sewer Pipe @.25	11 50			
72-31	10' 4" Iron " @.50	5 00		Aug. 5 1931 - Cash	72 25
	Sulphur & Jute	1 84			
	Trucking	<u>75</u>	19 09		
7/31	70 Hrs. Labor @.55	38 50			
	8 " " @.60	<u>4 80</u>	43 30		
	15% Overhead		<u>6 50</u>		
			68 89		
Sept. 29	Refund		<u>3 36</u>		
			72 25		
	Labor				

TOWN OF LEXINGTON—BOARD OF PUBLIC WORKS

SEWER DIVISION

DATE July 31, 1931

NO. Lot 43 Smith Ave


The undersigned applies for the construction of a particular sewer connecting No. 43 Smith Ave Street and hereby agrees to comply with the Rules and Regulations governing the construction and use of Particular Sewers, as now or at any future time established by the Board of Selectmen.

Am't. of Estimate \$ _____

Am't. Paid \$ _____

Burke & Chamberlain Owner
By H. Chamberlain

Sketch of Service Here

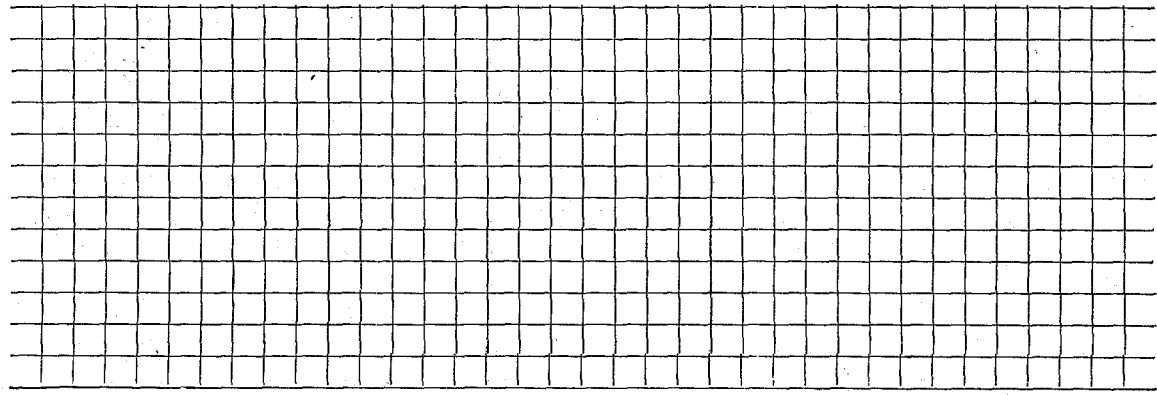

Connection made in _____ Street.

Work completed _____ 19

Remarks: