




\*

DATE \_\_\_\_\_

# TOWN OF LEXINGTON — BOARD OF PUBLIC WORKS

## SEWER DIVISION

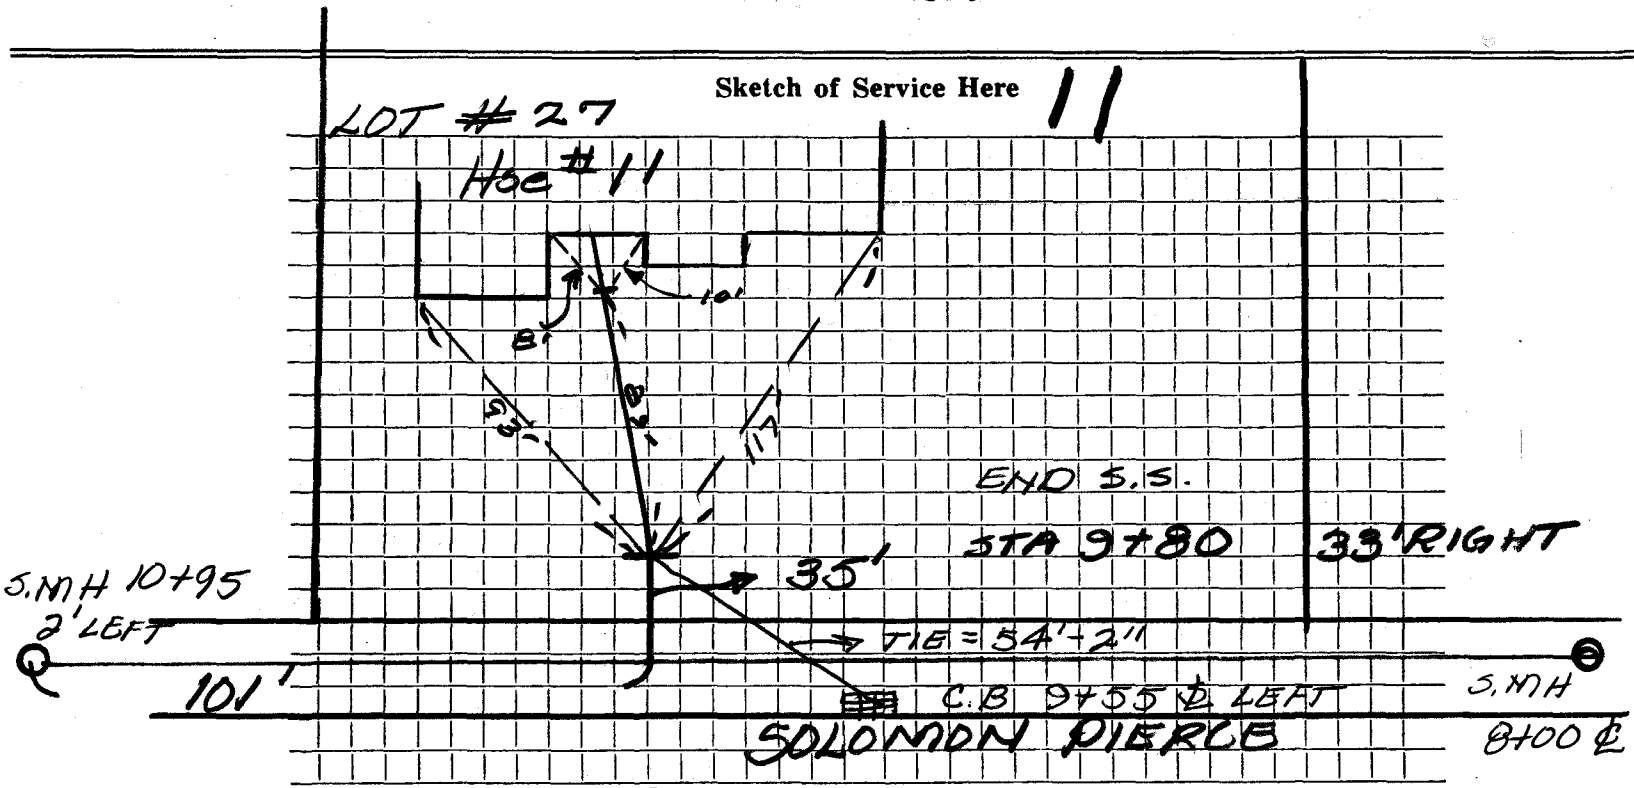

Connection made in ... SOLOMON PIERCE Street. Work completed .....

Remarks: ... DEPTH = 6' .....