


DATE _____

TOWN OF LEXINGTON — BOARD OF PUBLIC WORKS
SEWER DIVISION

LOT 28

Sketch of Service Here 15

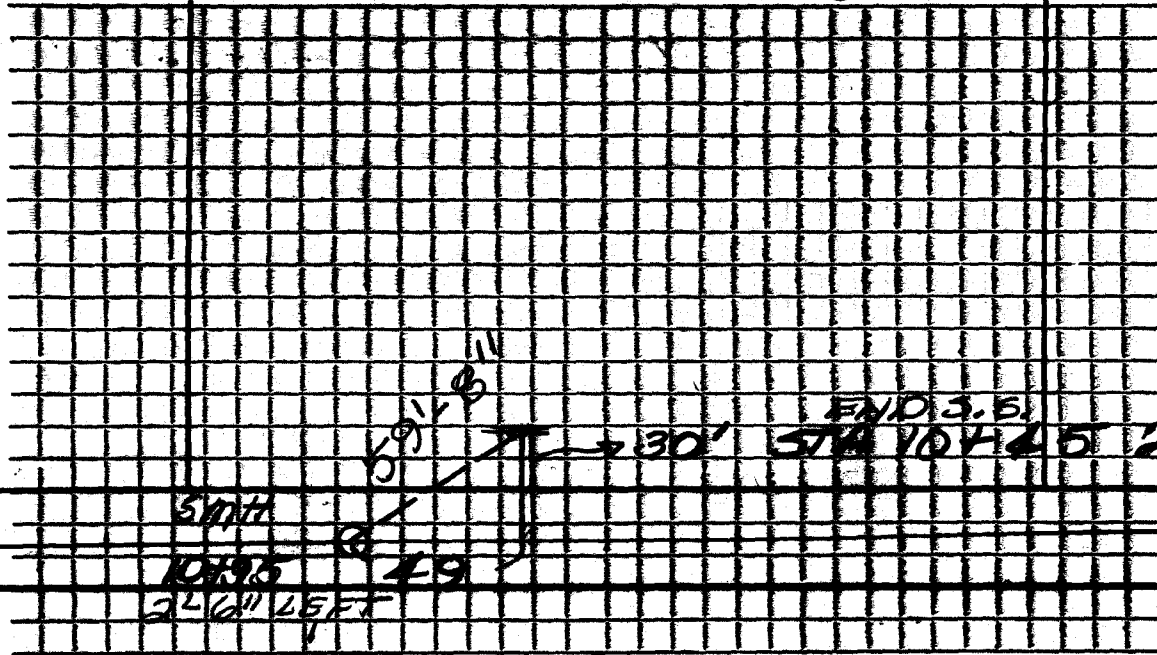

Connection made in SOLDMON PIERCE Street. Work completed


Remarks: DEPTH = 6'

.....
.....

DATE 8-29-05

TOWN OF LEXINGTON — BOARD OF PUBLIC WORKS
SEWER DIVISION

Sketch of Service Here

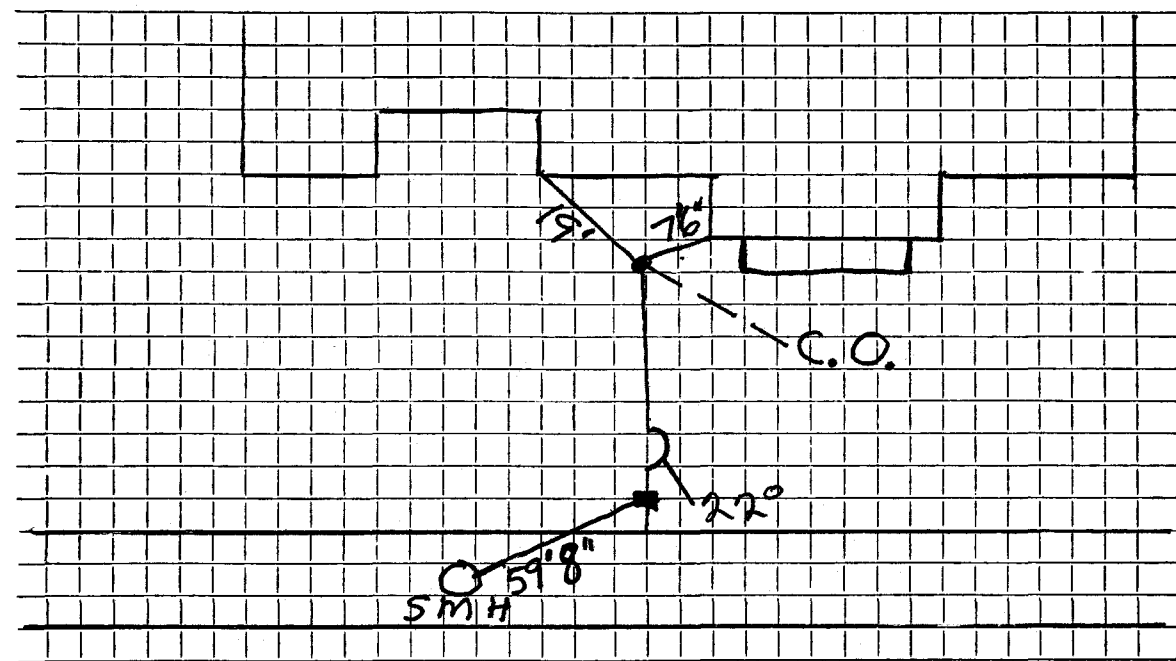

Connection made in Street. Work completed

Remarks:
.....
.....