


*

DATE _____

TOWN OF LEXINGTON — BOARD OF PUBLIC WORKS

SEWER DIVISION

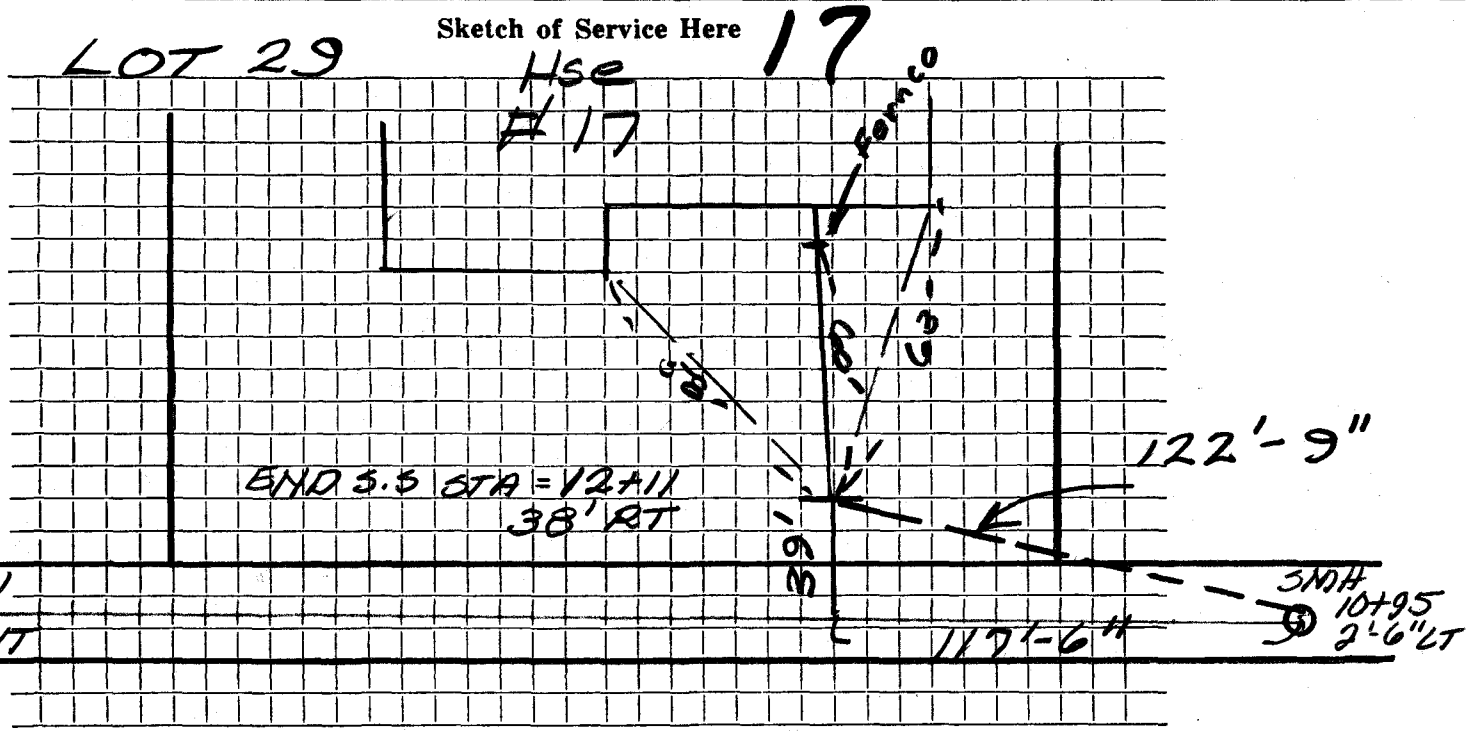

Connection made in SOLOMON PIERCE Street. Work completed

Remarks: DEPTH = 7'

.....