


TOWN OF LEXINGTON — BOARD OF PUBLIC WORKS

SEWER DIVISION

LOT # 20

Sketch of Service Here 18

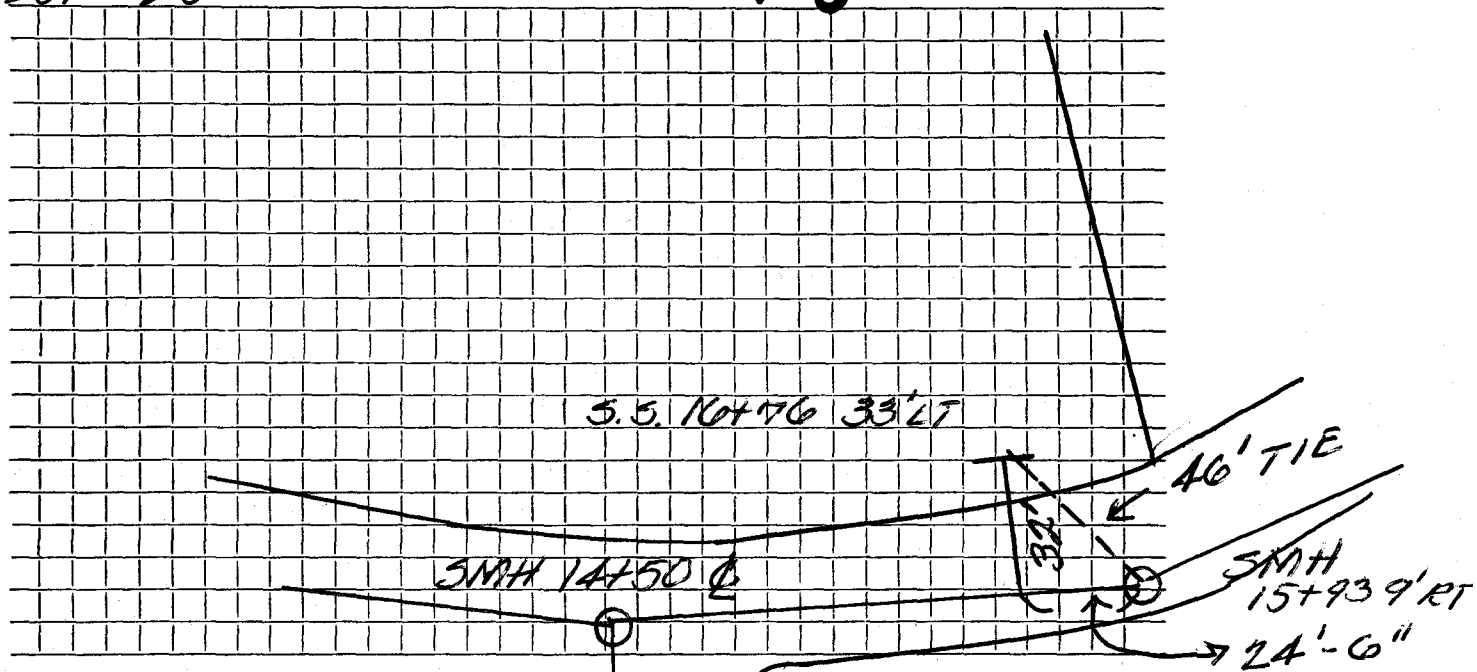

Connection made in Street. Work completed

Remarks:
.....
.....