

DATE _____


TOWN OF LEXINGTON — BOARD OF PUBLIC WORKS

SEWER DIVISION

Sketch of Service Here

LOT # 48

19

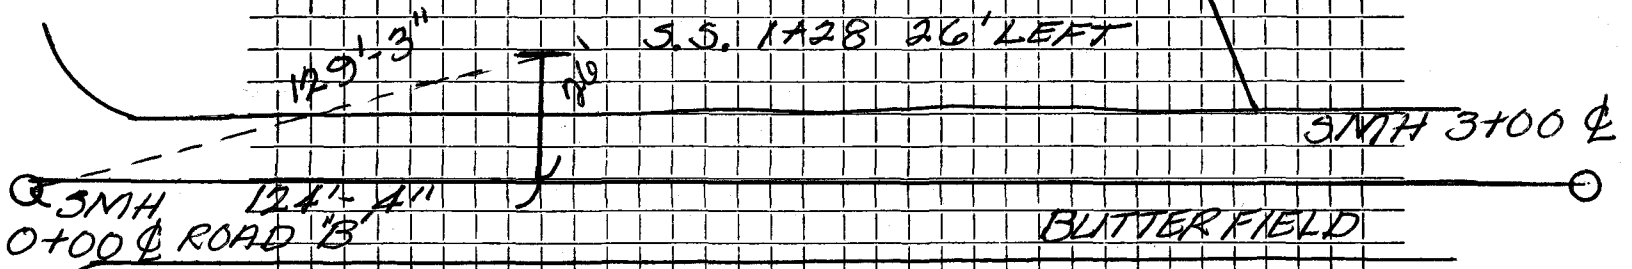

Connection made in BUTTER FIELD Street. Work completed

Remarks: DEPTH = 8'